


Basin 5
Dist 11
44477

RECEIVED
DEC 15 1967
STATE ENGINEER
JAMES L. JORDON

MOUND OF STONE
FC N, S, E, & W

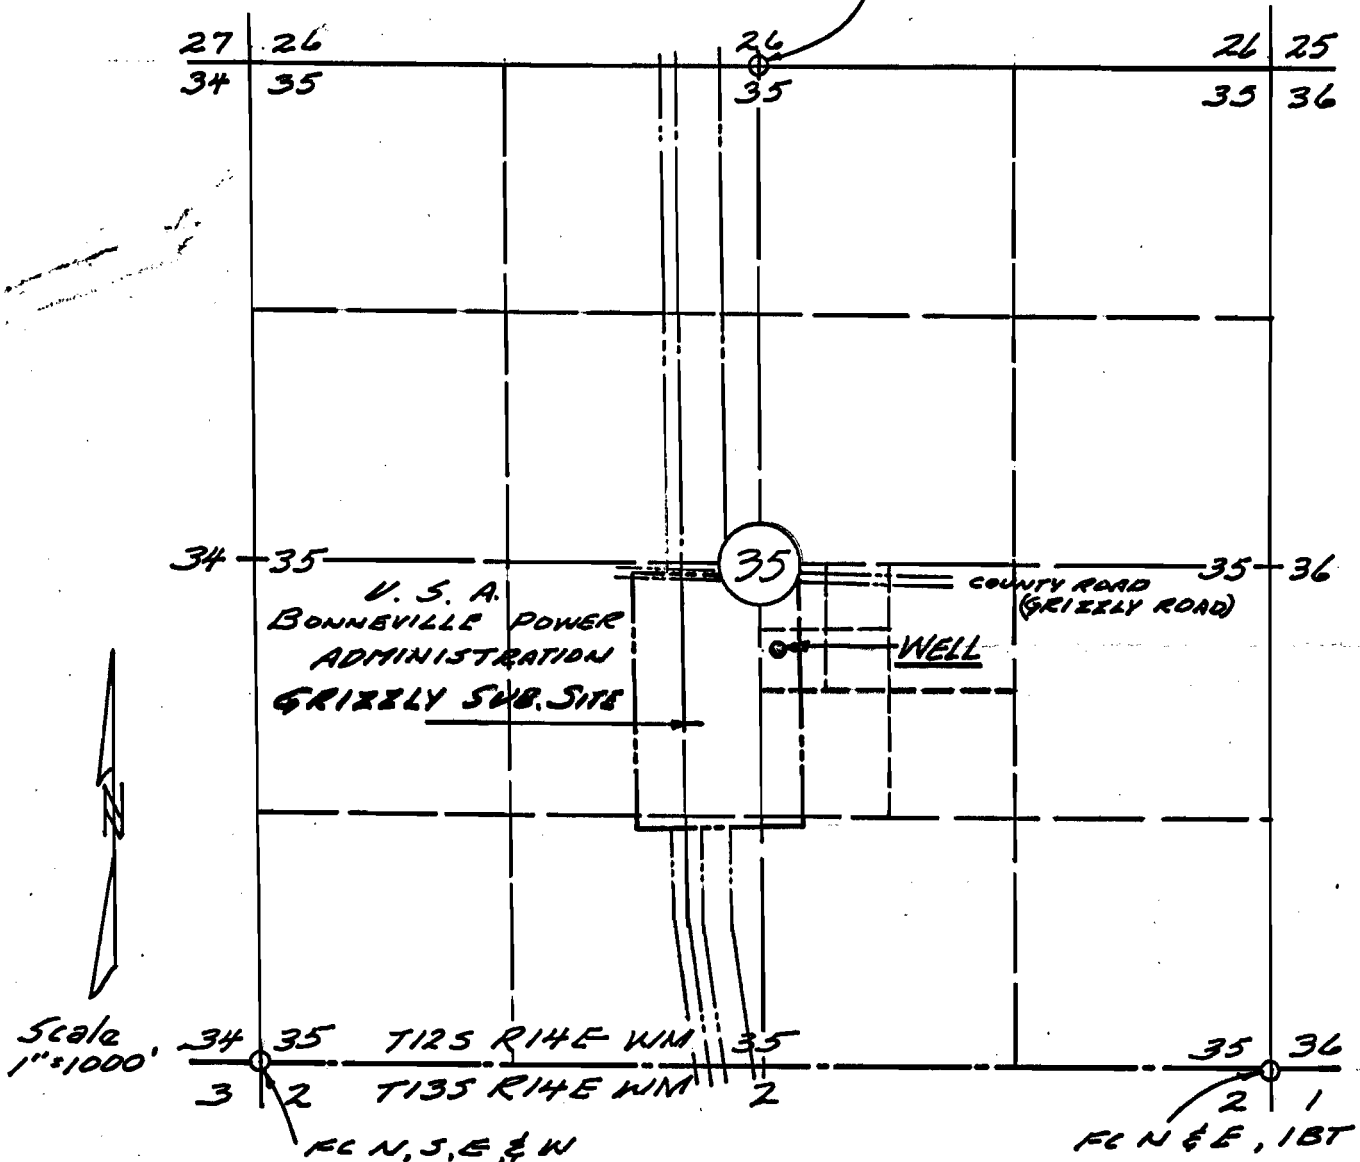

WELL IN SW $\frac{1}{4}$ NW $\frac{1}{4}$ SE $\frac{1}{4}$ SEC 35
T12S R14E WM JEFFERSON CO. OREG
2200 FT NORTH & 2550 FT WEST OF S.W. COR.

Application No. G-3247
Permit No. G-3002

G-3002