


T.37S. R.5W. W.M.

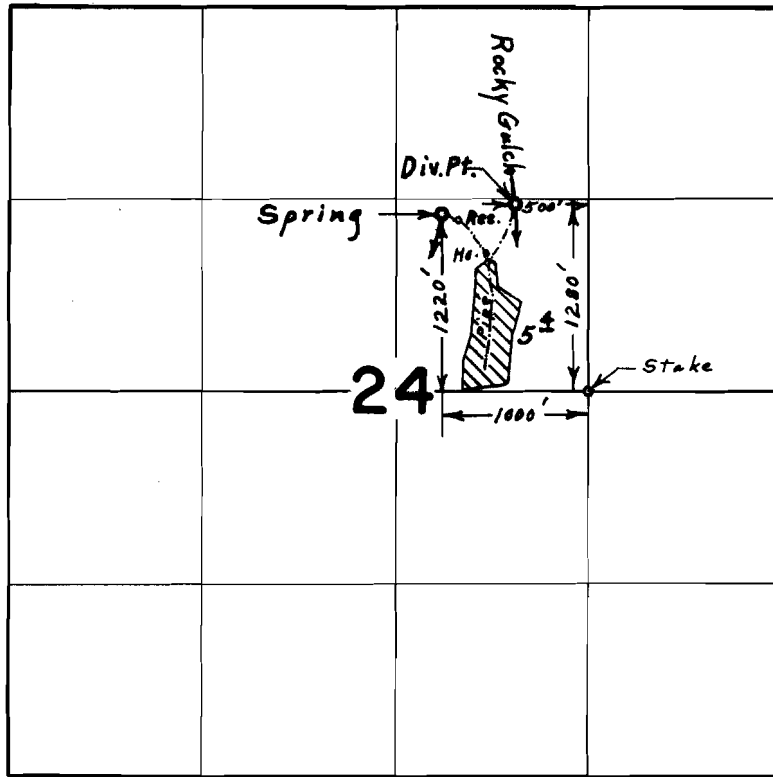

FINAL PROOF SURVEY
UNDER

Application No. 42027 Permit No. 31448
IN NAME OF

DONALD F. & MABLE C. MILBURN

Surveyed May 15, 1975, by L. E. Gould