


T.37 S., R.7 W., W.M.

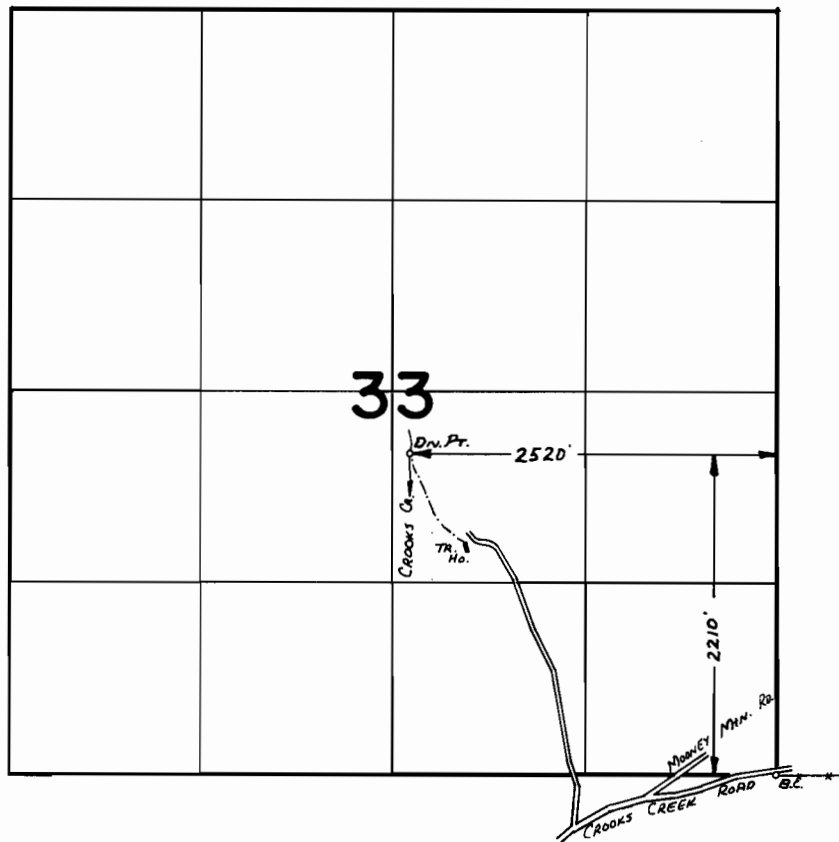

FINAL PROOF SURVEY
UNDER

Application No. 44468 Permit No. 33260
IN NAME OF

.....
Surveyed MAY 4 1976, by L. T. H......