


T.34S. R.7&8W. W.M.

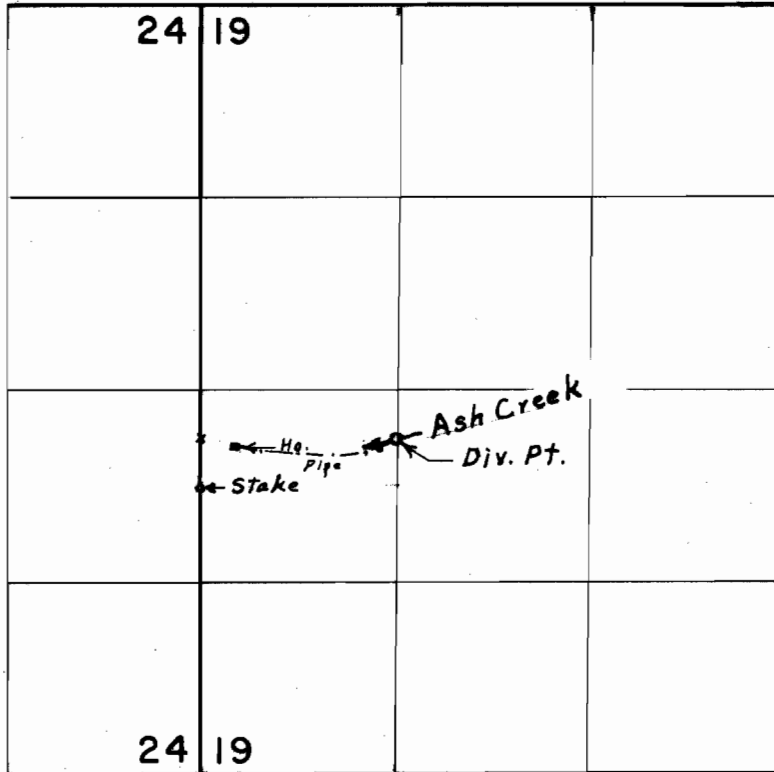

Div. Pt. loc. 340' N. & 1340' E. From S.W. Cor. N. $\frac{1}{4}$ N.W. $\frac{1}{4}$ S.W. $\frac{1}{4}$ Sec. 19

FINAL PROOF SURVEY
UNDER

Application No. 46912 Permit No. 35096

IN NAME OF

VIRGIL E. HULL

Surveyed April 7, 1975, by L. E. Gauld