


T.35S. R.7W. W.M.

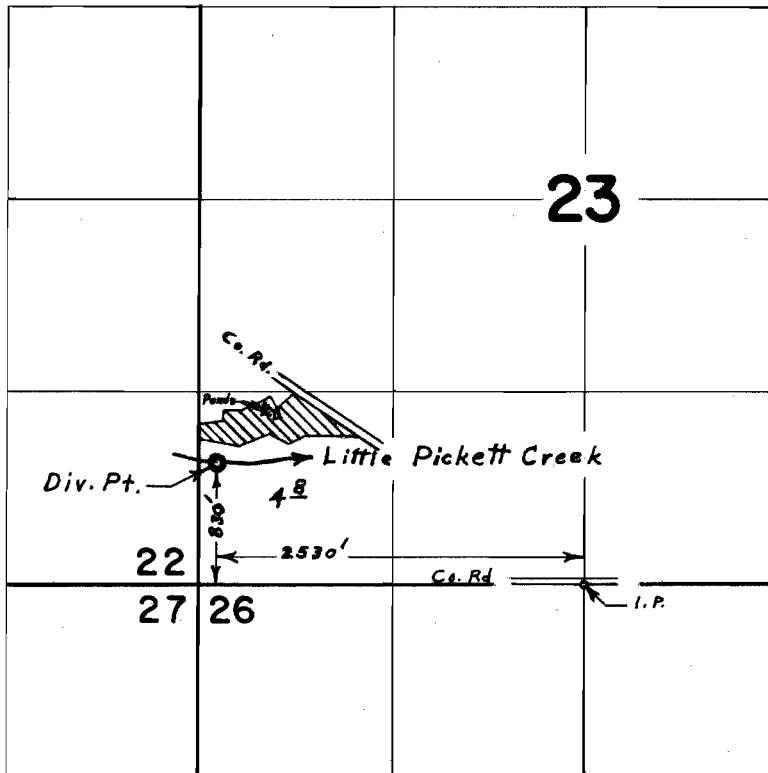

FINAL PROOF SURVEY
UNDER

Application No. 46922 Permit No. 35102
IN NAME OF
VERN E. & MARY E. HERRICK
LORAN A. & ALICE K. WRIGHT

Surveyed April 4, 1975, by L. E. Gould