


T.37S. R.7W. W.M.

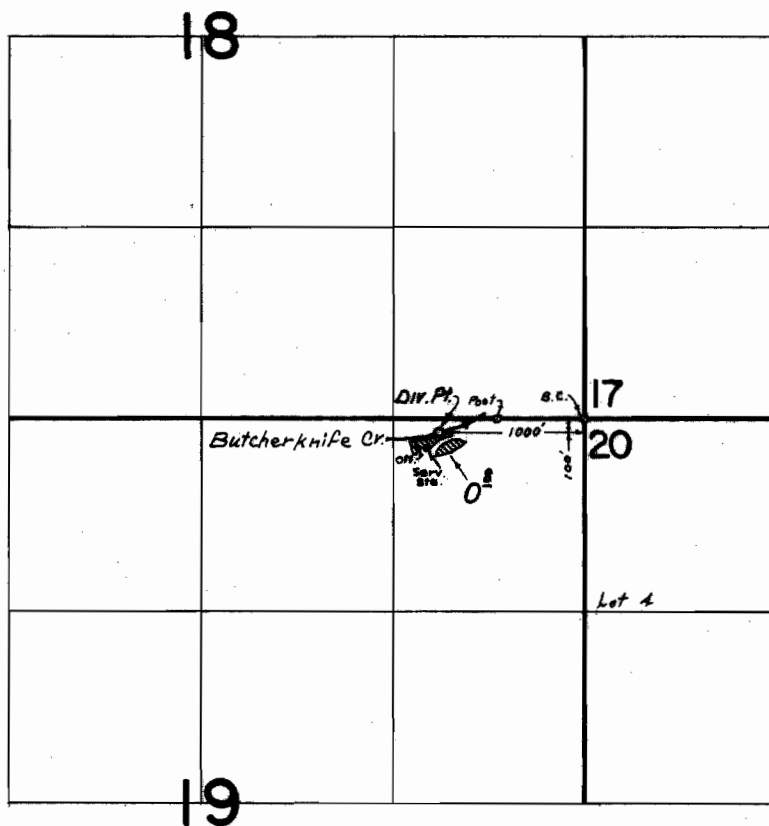

**FINAL PROOF SURVEY**  
UNDER

Application No. 47008 Permit No. 35167  
IN NAME OF

MS. M. W. BILDING

Surveyed MAY 21, 1974, by L. E. GOULD