


T.35 & 36 S. R. 7 W. W.M.

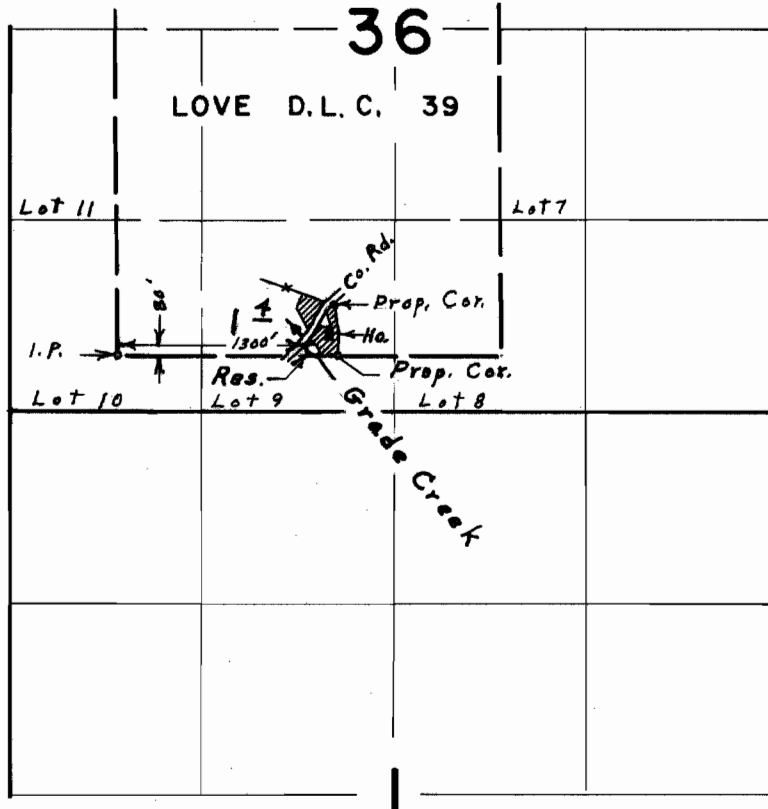

FINAL PROOF SURVEY
UNDER

Application No. R-47662 47663 Permit No. R-5741 35663
IN NAME OF

HOWARD N. WEST

Surveyed April 3, 1975, by L. E. Gould