


T.35 & 36 S. R. 7 W. W.M.

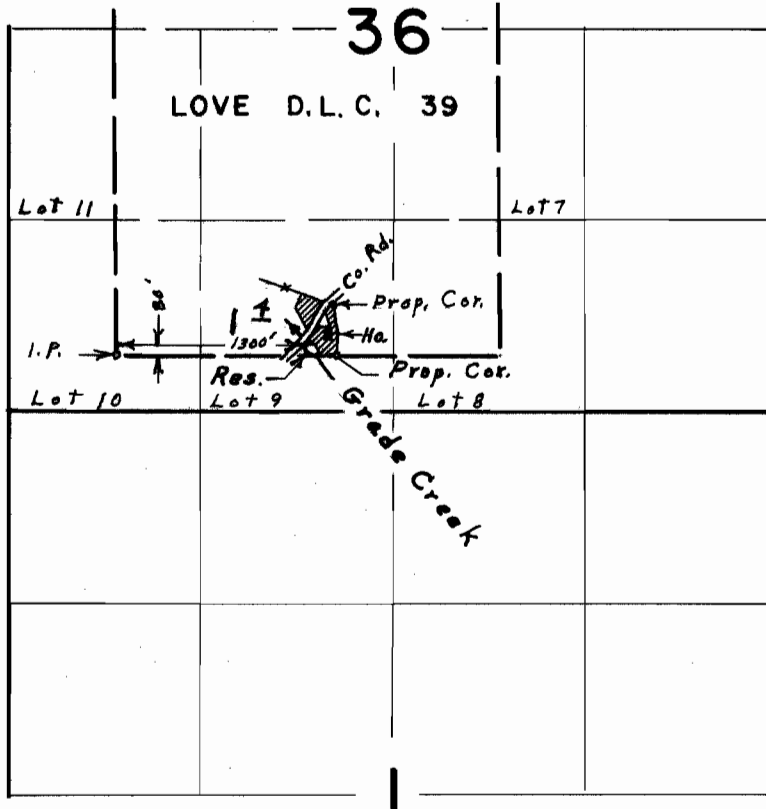

FINAL PROOF SURVEY
UNDER

Application No. ^{R-47662} ~~47663~~ Permit No. ^{R-5741} ~~35663~~
IN NAME OF

HOWARD N. WEST

Surveyed *April 3, 1975*, by *L. E. Gould*