


T.36 S. R.7 W. W.M.

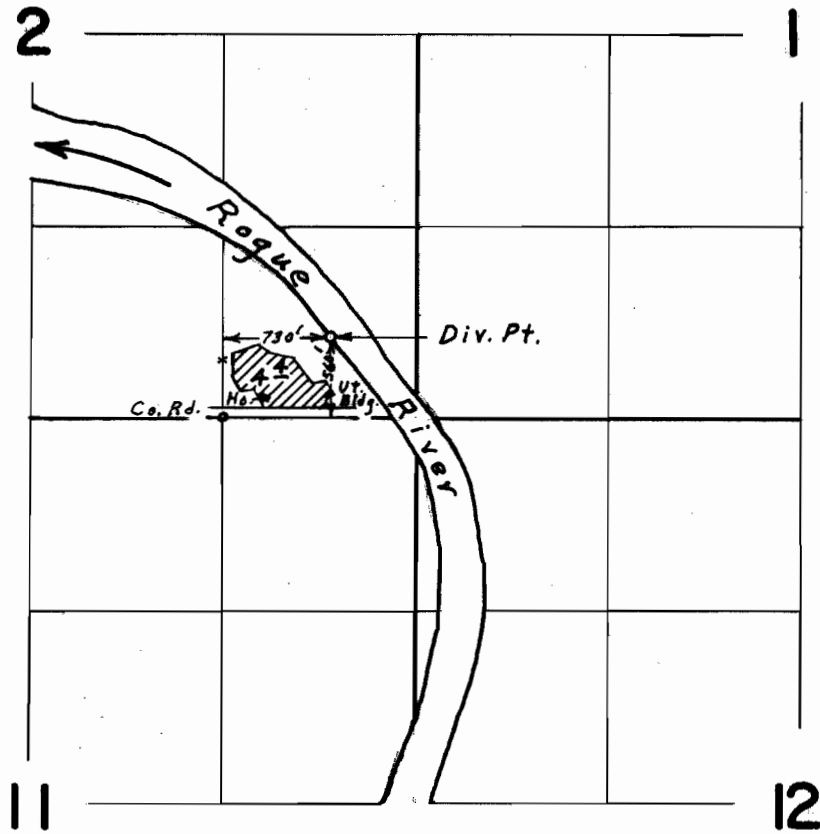

**FINAL PROOF SURVEY**  
UNDER

Application No. 47897 Permit No. 35891  
IN NAME OF

JOSEPHINE COUNTY BOARD OF COMMISSIONERS

Surveyed April 9, 1975, by L. E. Gould