


T.36 S. R.7 W. W.M.

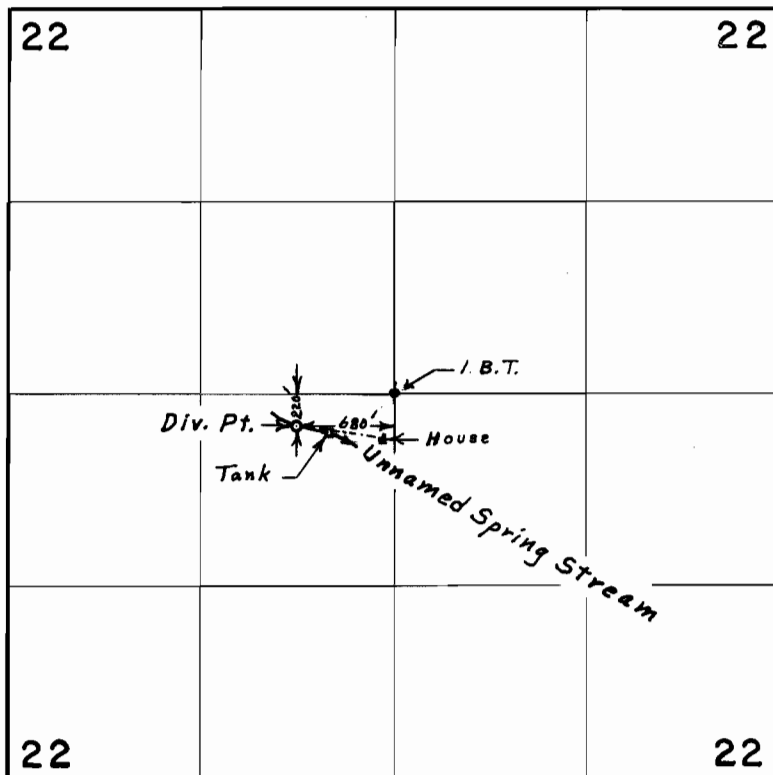

FINAL PROOF SURVEY
UNDER

Application No. 48124 Permit No. 36136
IN NAME OF

CHARLES H. BARRICK

Surveyed April 10, 1975, by L. E. Gould