


34878  
44490

# T.36S.,R.10E.,W.M.

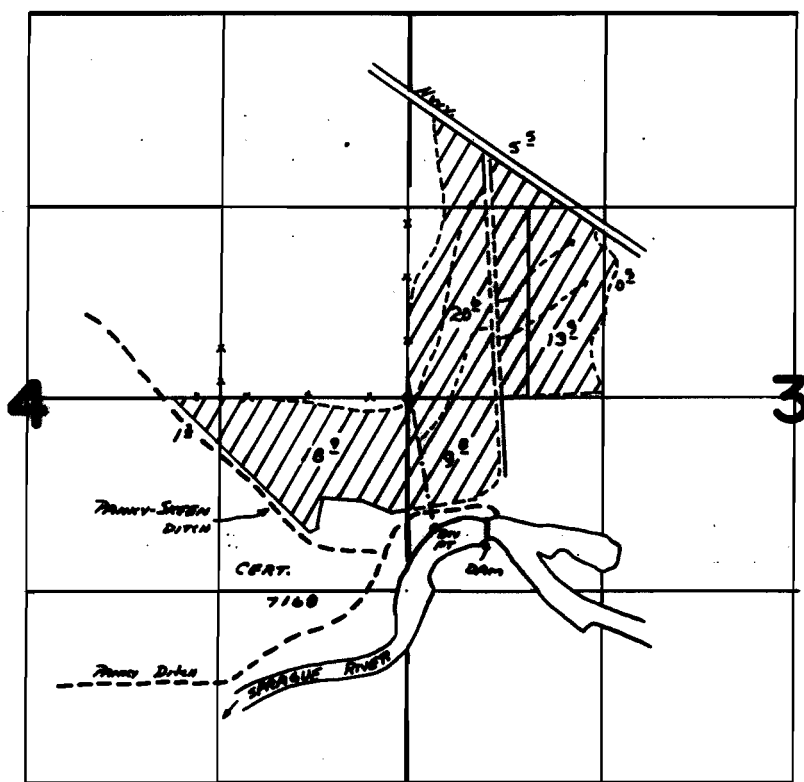

DIV. PT. - 876'S AND 200'E FROM W 1/4 COR SEC 3

Sprague Riv.

## FINAL PROOF SURVEY UNDER

Application No. 46932 Permit No. 34878<sup>40988-suppl.</sup>  
IN NAME OF

BILL & ROSALYN HARRIS

Surveyed July 10, 1975, by A.E. Gouge