


34908

44491

T.40S.,R.8E.,W.M.

Klamath River

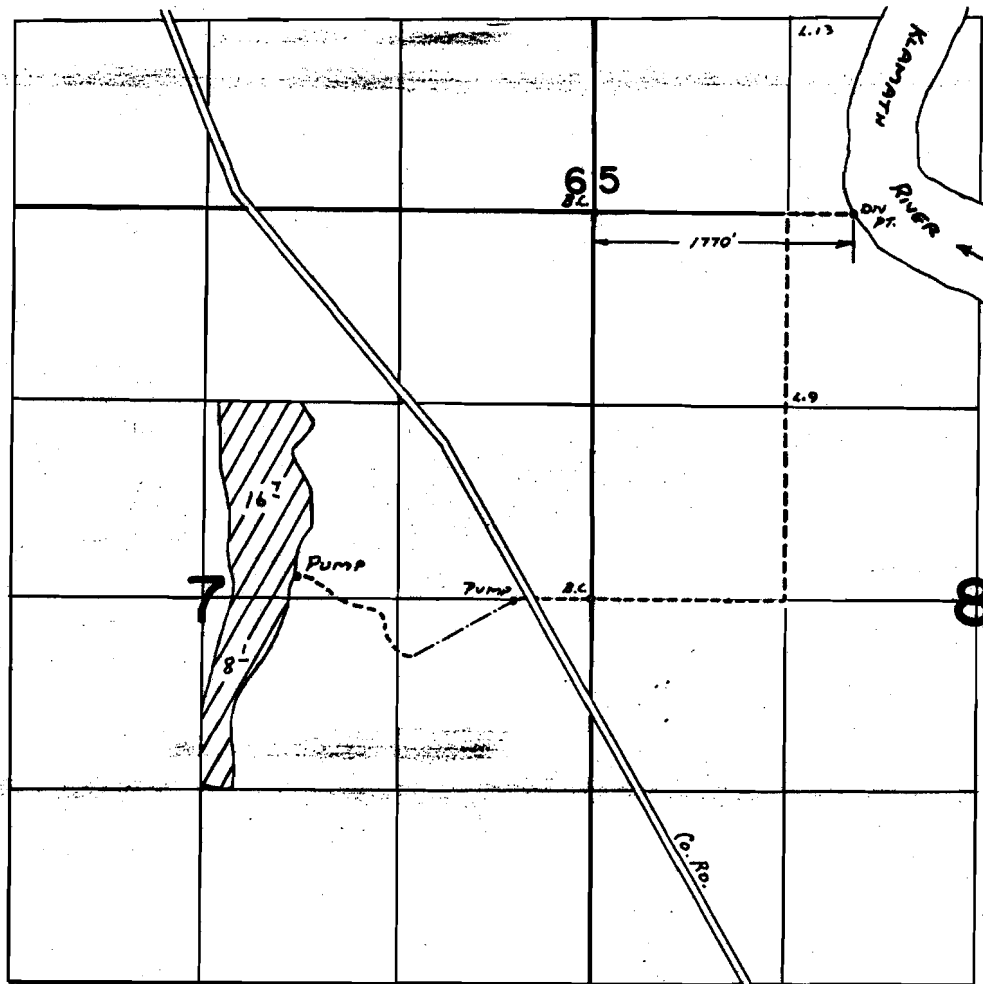

FINAL PROOF SURVEY UNDER

Application No. 46712 Permit No. 34908
IN NAME OF

LLOYD V. HOWARD

Surveyed JULY 15, 1975, by L. E. GARDNER