36897

44492

T.39S.,R.8E.,W.M.

Klamath Co. mise.

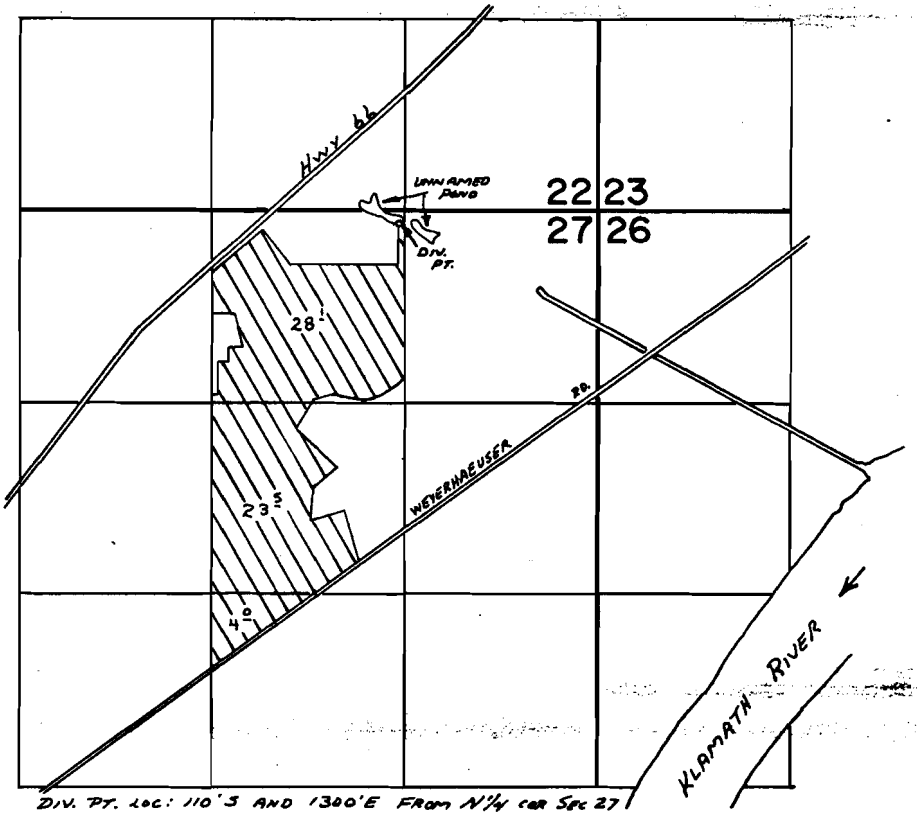

FINAL PROOF SURVEY
UNDER

Application No. 49225 Permit No. 36897
IN NAME OF

MILDRED F. FITZGERALD

Surveyed July 12 1975, by L. E. Gould

CNO-133-171 WMT