


36208

44494

T. 28 & 29 S. R. 13 E. W.M.

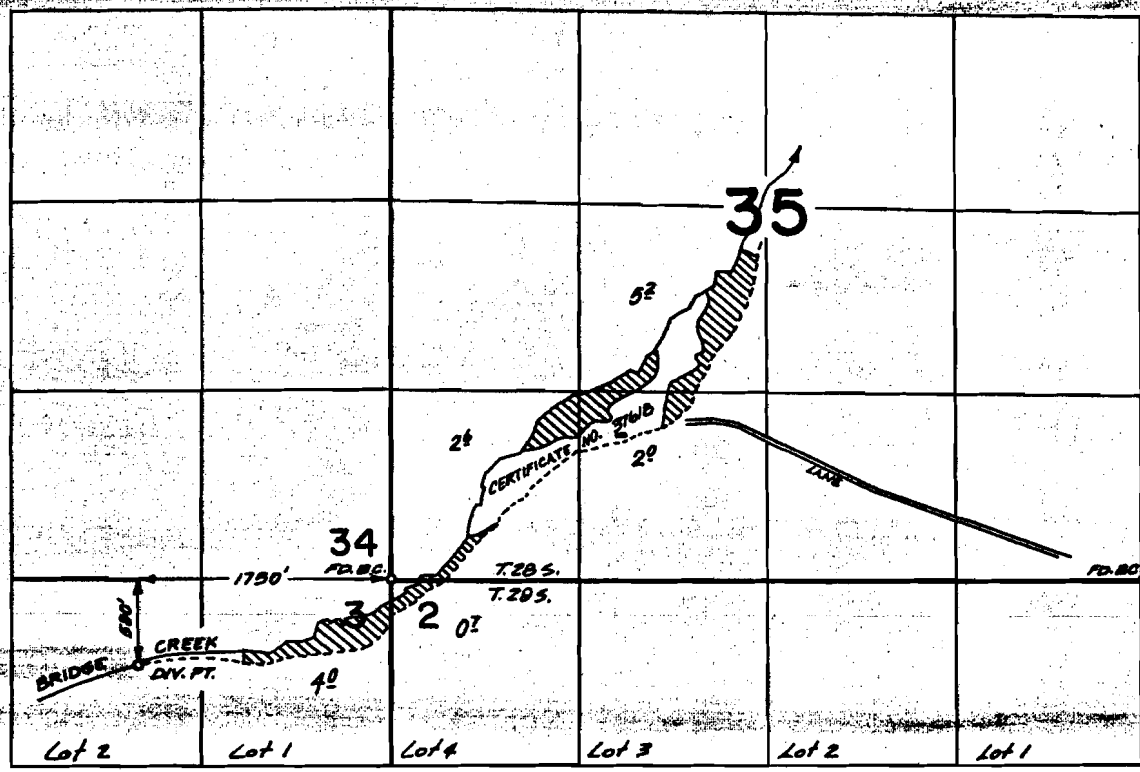

FINAL PROOF SURVEY UNDER

Application No. 48208 Permit No. 36208
IN NAME OF

JAMES H. or LORRAINE D. SPHAR

Surveyed JULY 23 1975, by R.G. Mucken