


T.33S. R.17E. W.M.

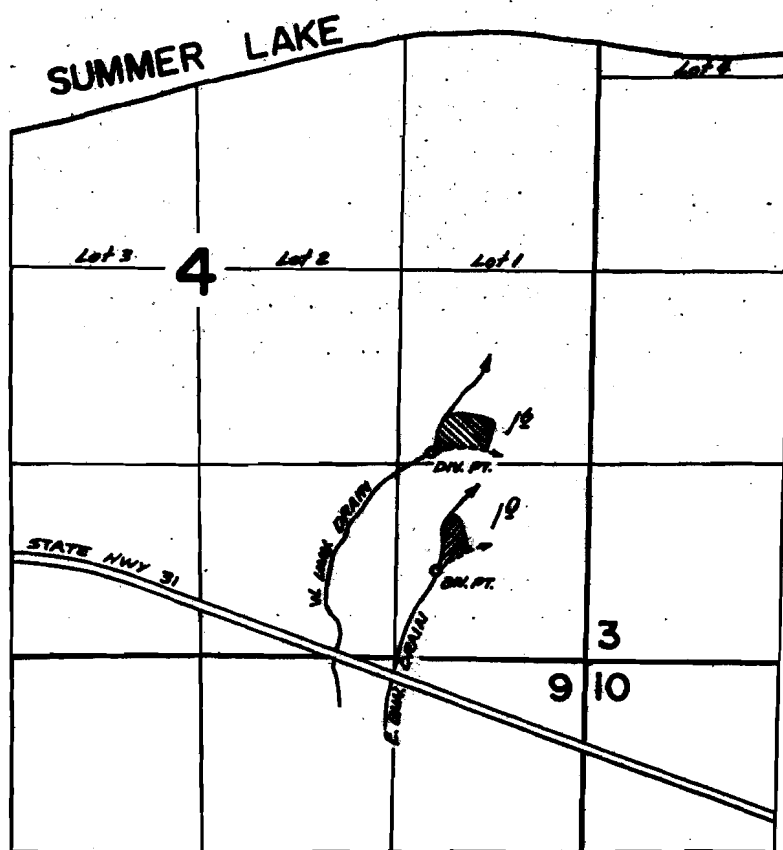

DNL PTS. - W. UNN. DRAIN, 1740' AL & 1100' W., E. UNN. DRAIN, 610' N. & 1040' W.
BOTH FROM S.E. COR. SEC. 4.

FINAL PROOF SURVEY **UNDER**

Application No. 49752 Permit No. 37253
IN NAME OF

WITHERS RANCH, INC.

Surveyed JULY 30 1975, by R.G. MUCKEN