


T.18 S. R.5 W. W.M.

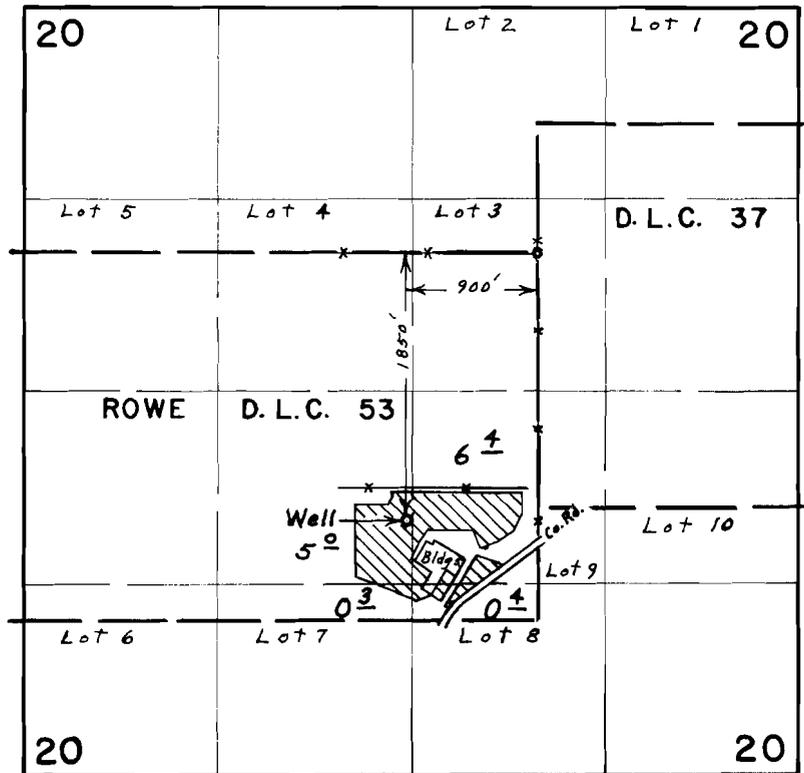

FINAL PROOF SURVEY UNDER

Application No. G-5072 Permit No. G-4725
IN NAME OF

LANE COUNTY SCHOOL DISTRICT NO. 66

Surveyed Nov. 4, 1975, by L. E. Gould