


T.18S. R.5W. W.M.

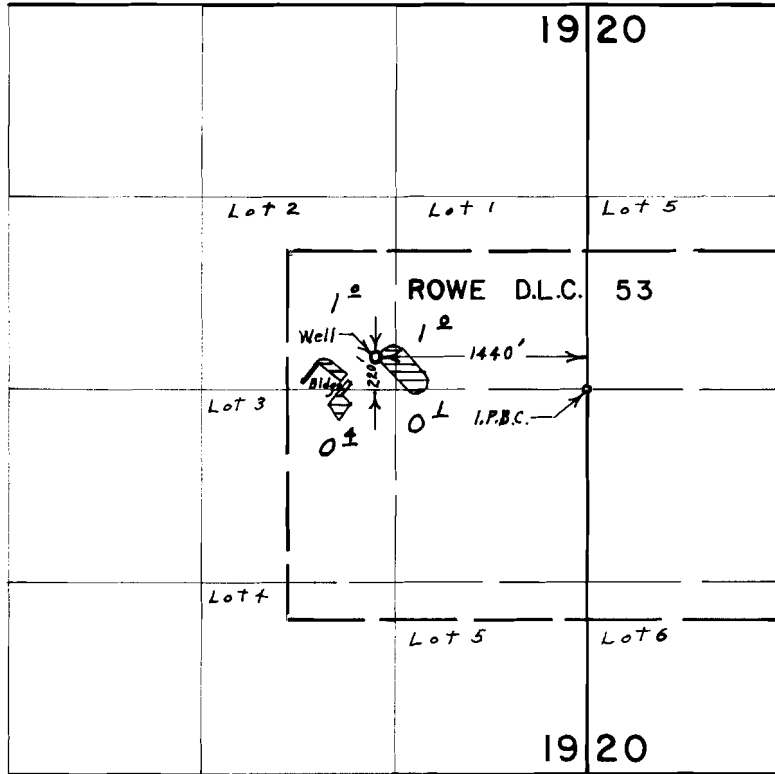

FINAL PROOF SURVEY
UNDER

Application No. G-5080 Permit No. G-4796
IN NAME OF
LANE COUNTY SCHOOL DISTRICT NO. 66

Surveyed Max...t., 1975, by L. E. Gould