


T.17S.,R.6W.,W.M.

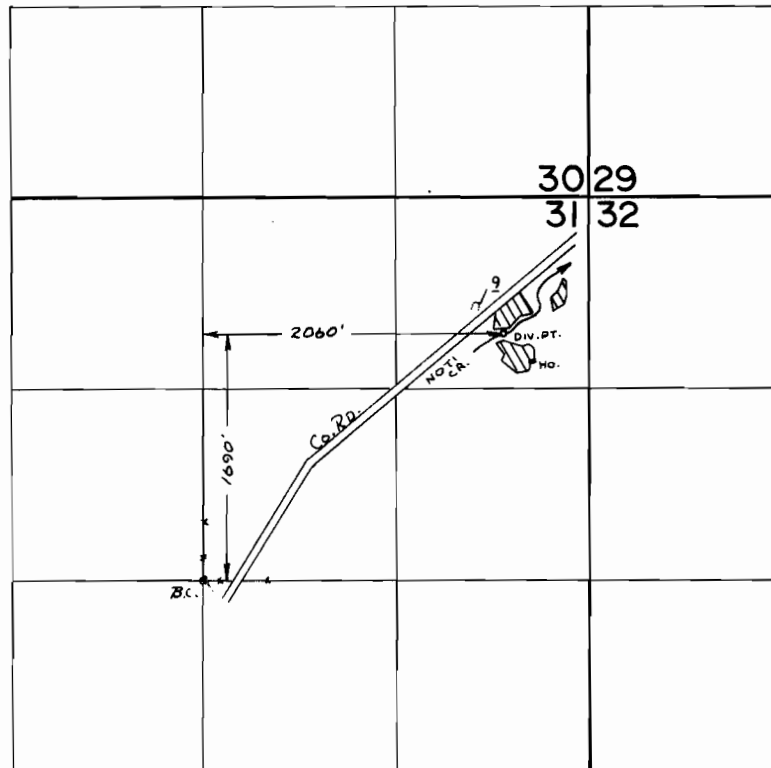

FINAL PROOF SURVEY
UNDER

Application No. 42805 Permit No. 32001
IN NAME OF

VINCENT J. CLARIC

Surveyed SEPT. 17, 1975, by L. T. O. H.

PTS 1974-K
PTS 1975-VV