


T.16S. R.6W. W. M.

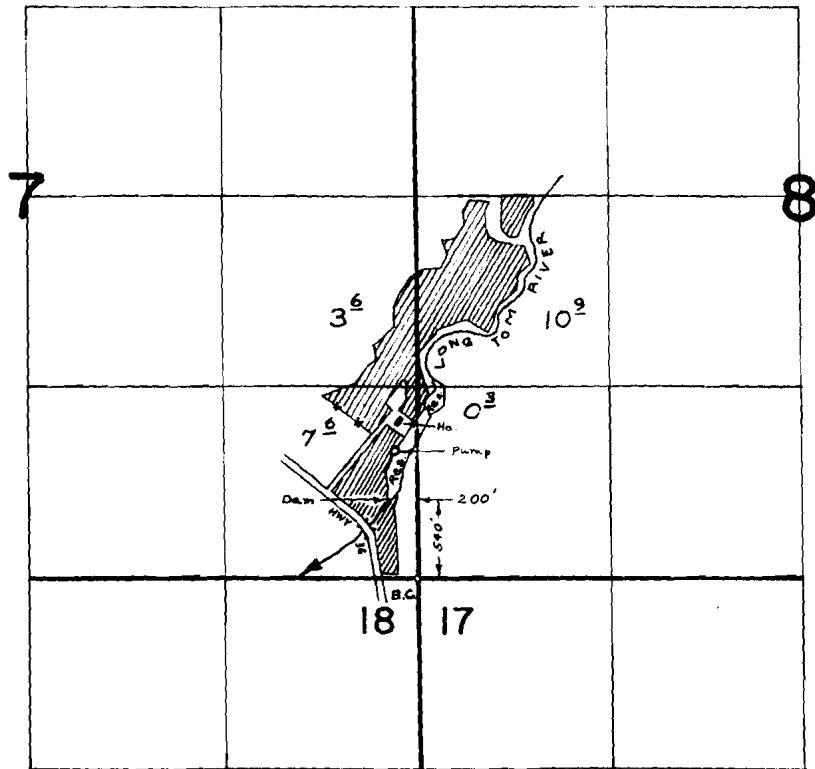

FINAL PROOF SURVEY
UNDER

R-42763 R-4911
Application No. 42734 Permit No. 32199
IN NAME OF
IRWIN & SONS

Surveyed MAY 7, 1975, by R. MUCKEN