


T.17S. R.6W. W.M.

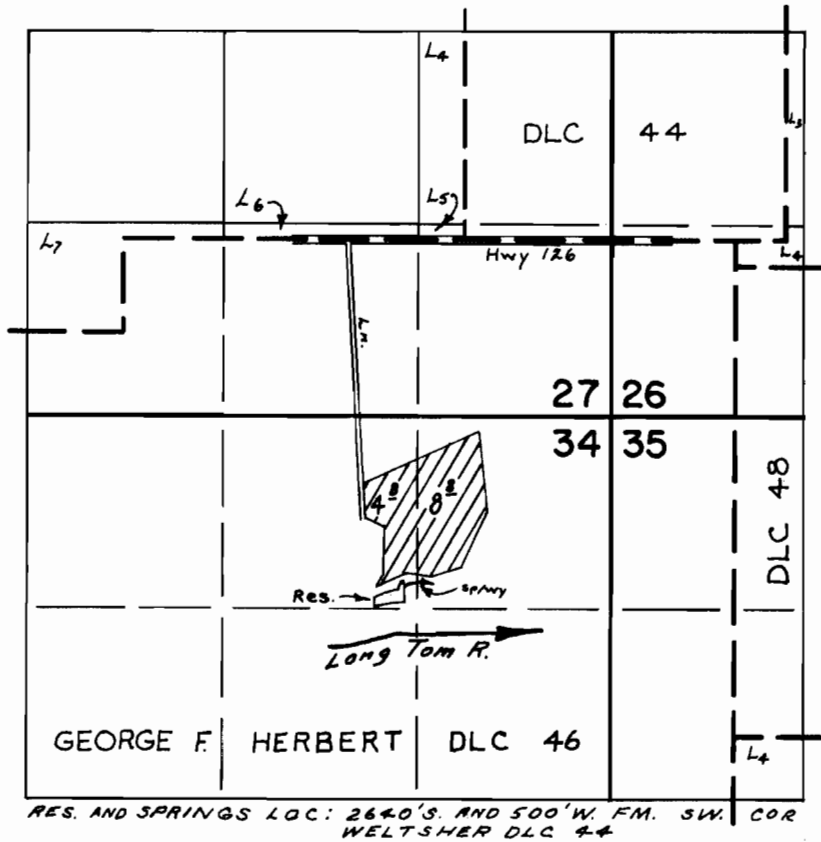

FINAL PROOF SURVEY
UNDER

Application No. 44035 Permit No. 32911
R-44314 IN NAME OF

PAUL B. HERRINGTON

Surveyed May 7, 74 by T. Paul
April 28, 1975, by R. Mucken