


T.17S. R.6W. W.M.

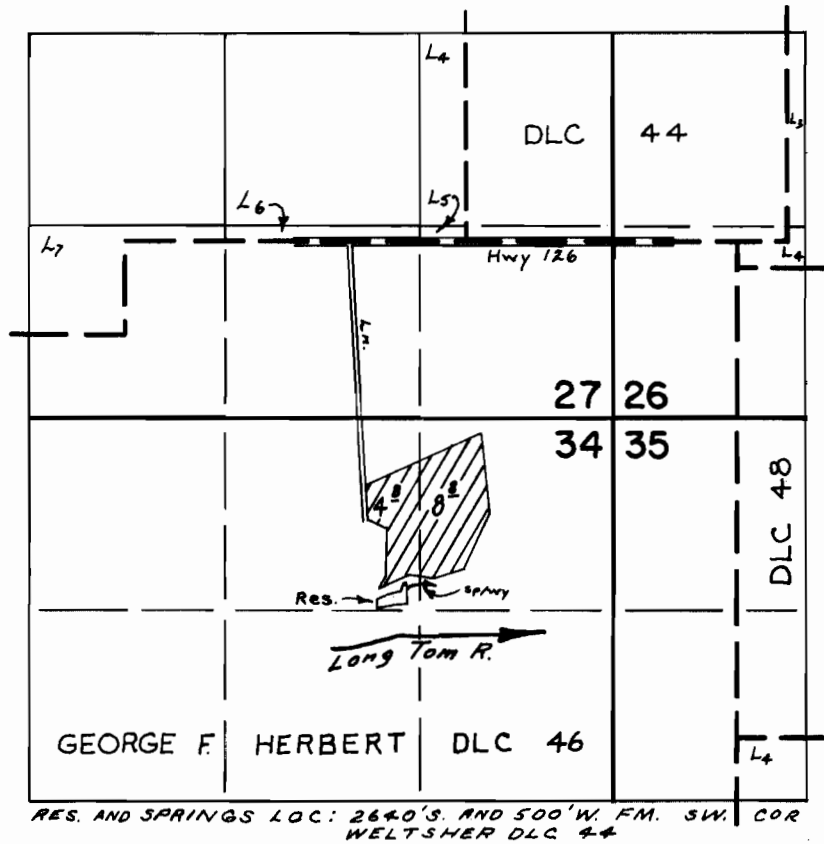

FINAL PROOF SURVEY
UNDER

Application No. 44035 32911
R-44314 Permit No. R-5081
IN NAME OF

PAUL B. HERRINGTON

Surveyed May 7, 74 T. Paul
April 28, 1975, by R. Mucken