


T. 17S. R. 6W. W.M.

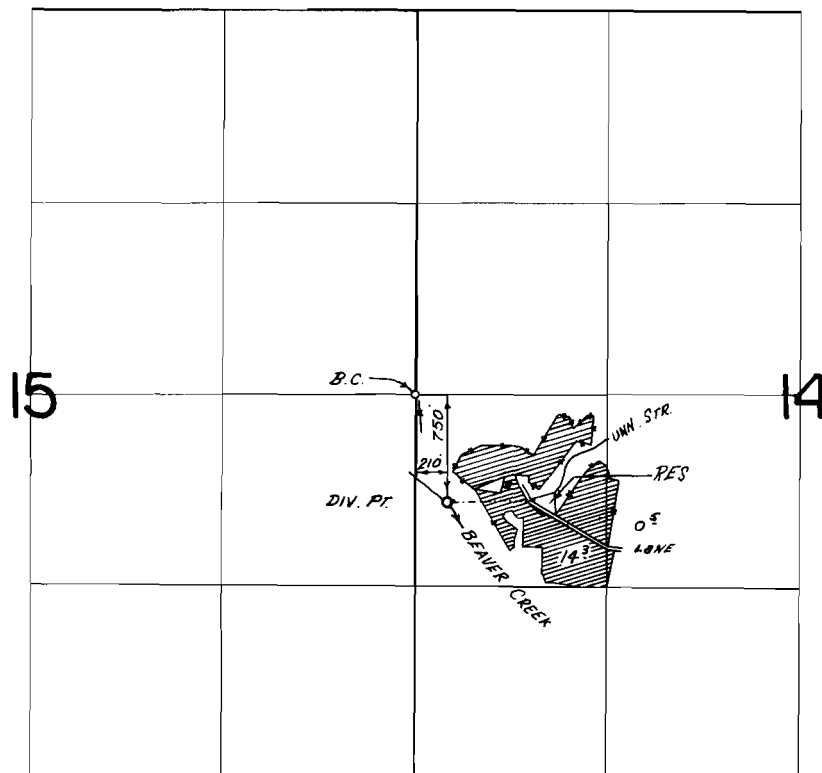

FINAL PROOF SURVEY
UNDER

Application No. 45128 Permit No. 33280
IN NAME OF
GEORGE J. & BARBARA A. WOODRICH

Surveyed May 7 1974, by T. J. PAUL