


T.17S. R.8W. W. M.

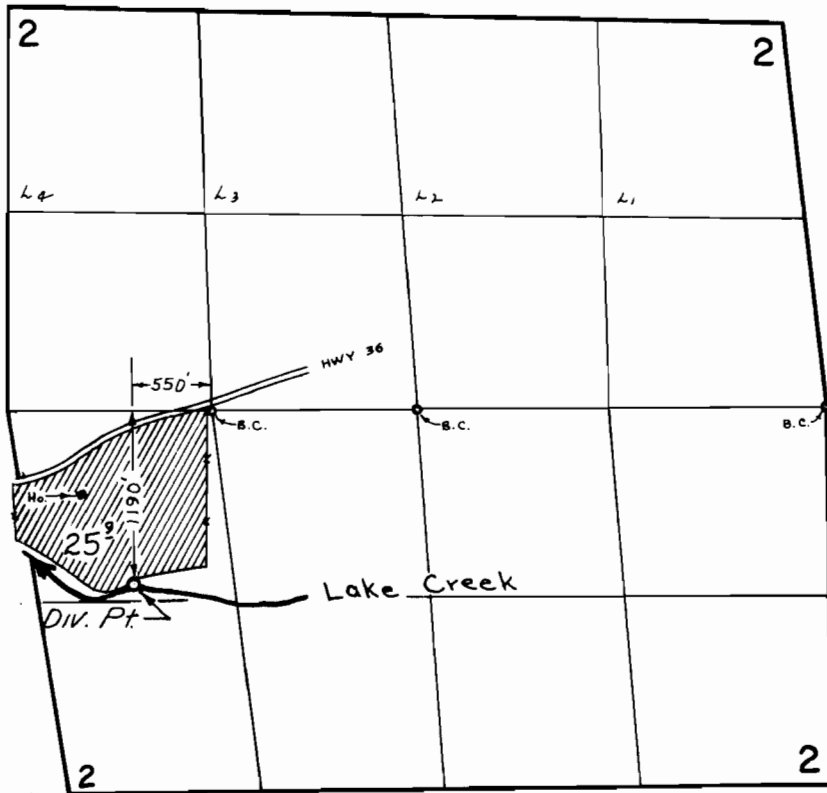

FINAL PROOF SURVEY
UNDER

Application No. 46589 Permit No. 34663
IN NAME OF

ROLAND LEE RITCHIE

Surveyed May 8, 1975, by R. Mucken.