


T. 20 S. R. 5 W. W. M.

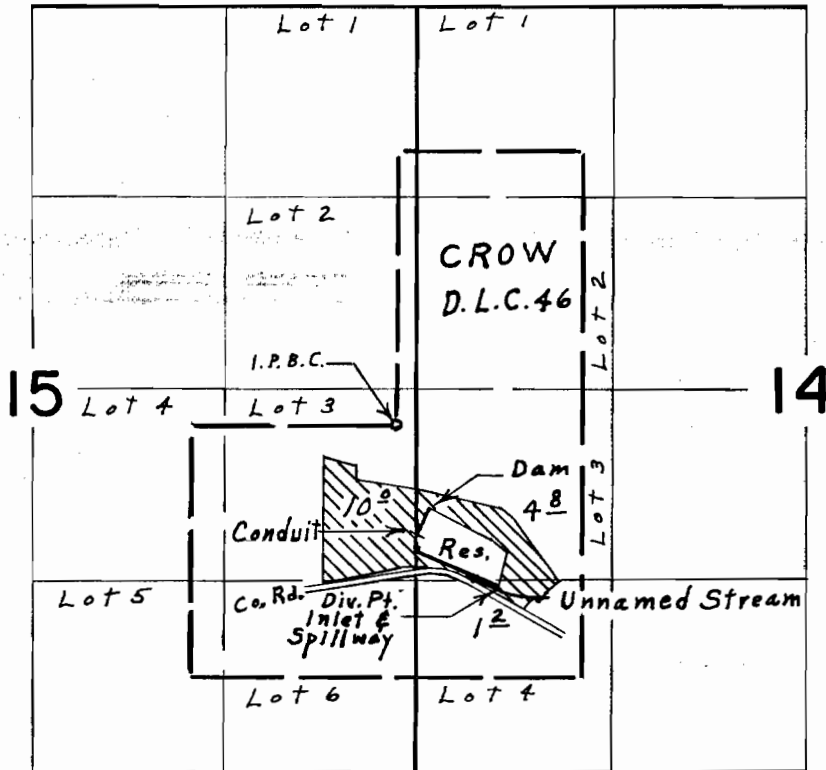

**FINAL PROOF SURVEY**  
UNDER

R-47029      R- 5584  
Application No. 47030      Permit No. 34887

IN NAME OF  
**DEY BROTHERS**

Surveyed March 27, 1975, by L. E. Gould