


T.16S. R.7W. W.M.

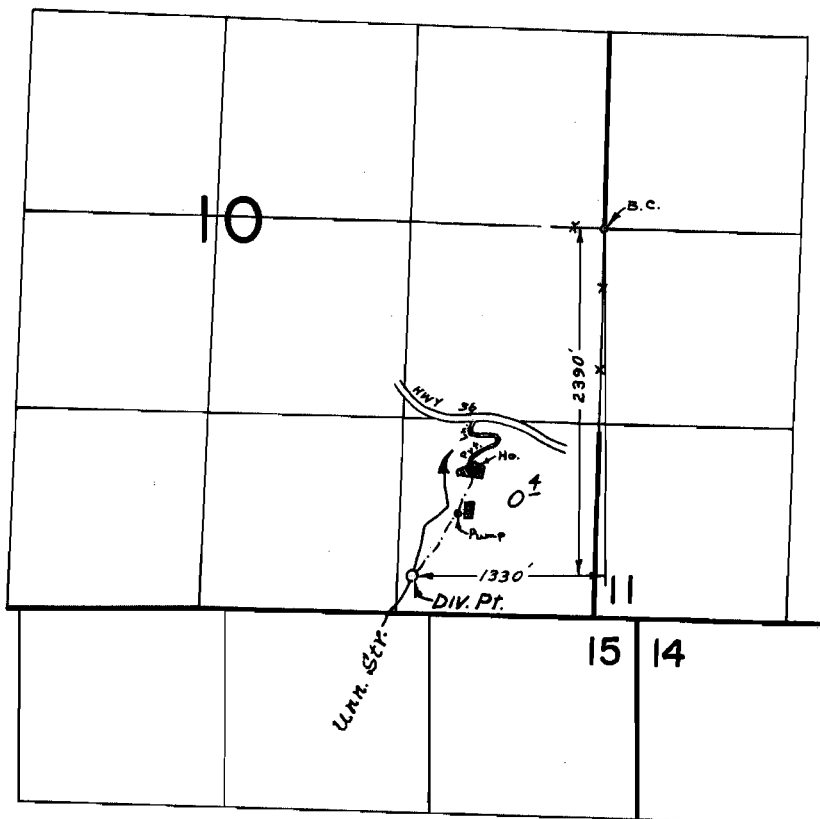

**FINAL PROOF SURVEY**  
UNDER

Application No. 48489 Permit No. 35503  
IN NAME OF

J. D. ADAMS

Surveyed May 7, 1975, by R. Mucken