


RECEIVED
 MAR 30 1971
 STATE ENGINEER
 SALEM OREGON

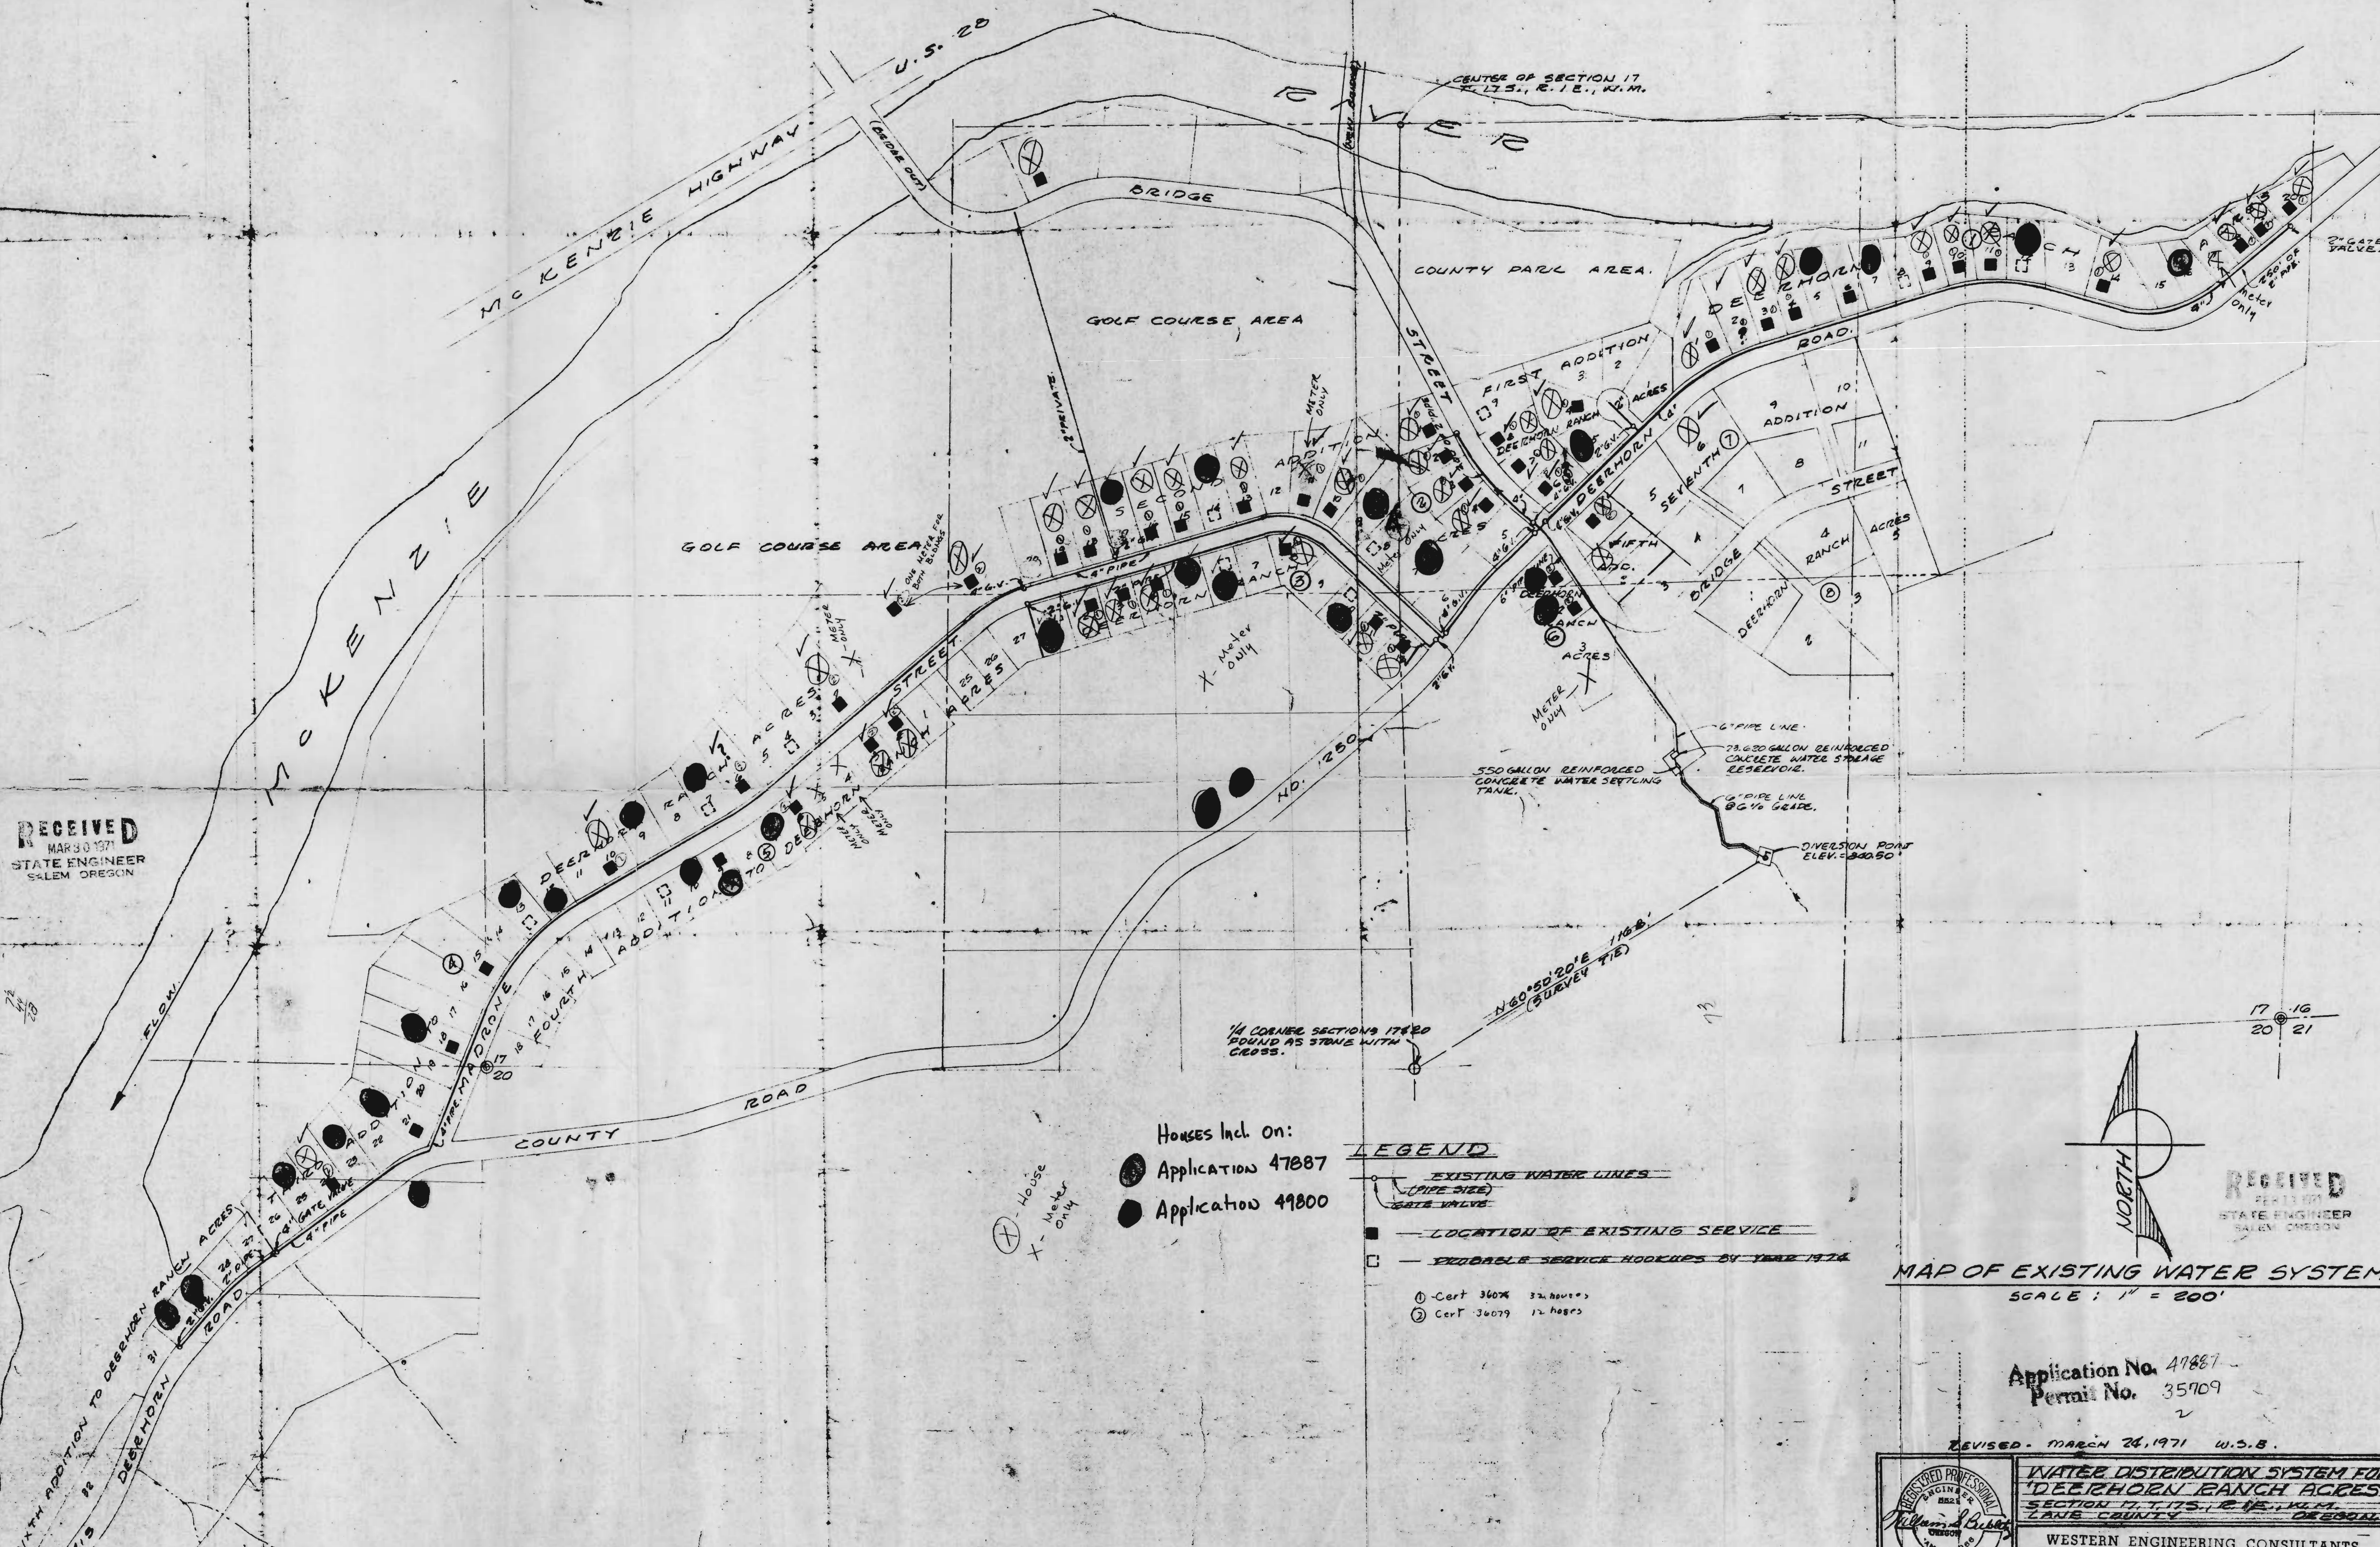

Houses Incl. on:
 ● Application 47887
 ● Application 49800


⊕ House
 ⊕ Meter only

- LEGEND**
- EXISTING WATER LINES (PIPE SIZE)
 - GATE VALVE
 - LOCATION OF EXISTING SERVICE
 - PROBABLE SERVICE HOOKUPS BY YEAR 1976
- ① - Cert 36078 32 houses
 ② - Cert 36079 12 houses

MAP OF EXISTING WATER SYSTEM
 SCALE: 1" = 200'

Application No. 47887
 Permit No. 35709

REVISED - MARCH 24, 1971 W.S.B.

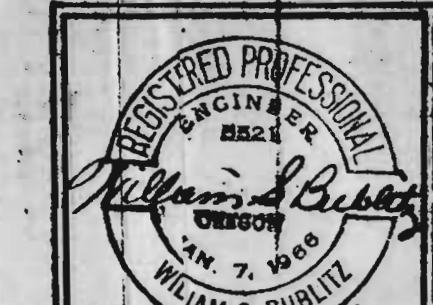

WESTERN ENGINEERING CONSULTANTS
 1445 WILLAMETTE STREET
 EUGENE, OREGON

RECEIVED
 STATE ENGINEER
 SALEM OREGON