


T.19S. R.2W. W.M.

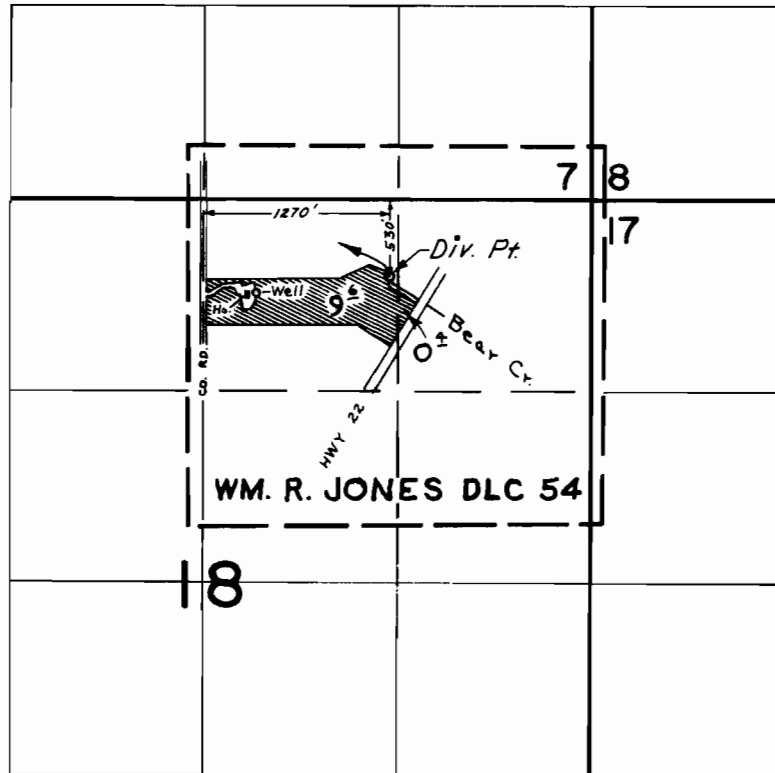

FINAL PROOF SURVEY
UNDER

Application No. 47905 Permit No. 35896
IN NAME OF

LAUDIE & ELSIE RAMBOUSEK

Surveyed April 16, 1975, by R. Mucken