


T.17S. R.6W. W.M.

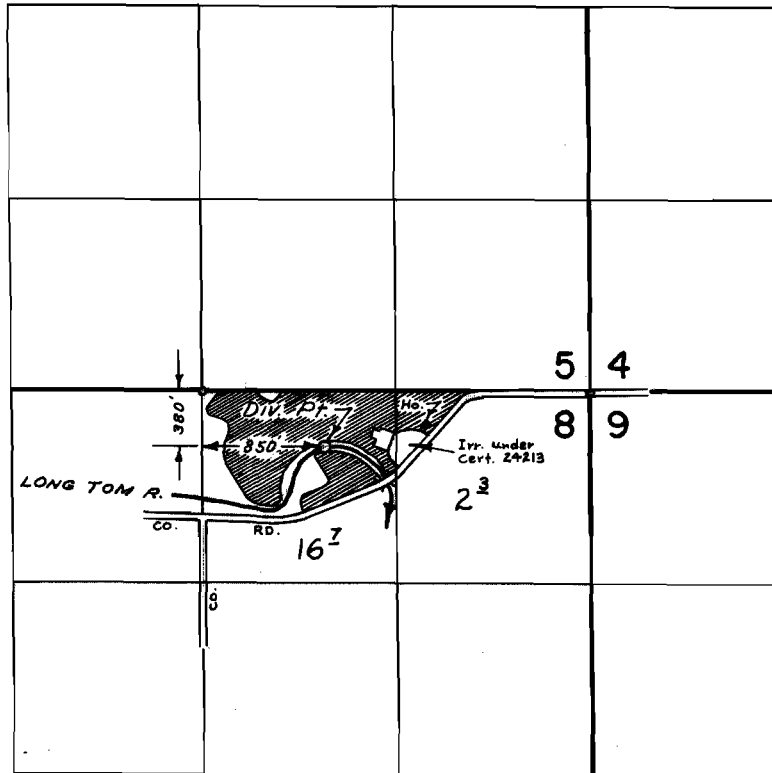

FINAL PROOF SURVEY
UNDER

Application No. 48521 Permit No. 36405
IN NAME OF

GERALD R. & LORRAINE E. HECKERT

Surveyed April 29, 1975, by R. Mucken