


T.17S.,R.1W.,W.M.

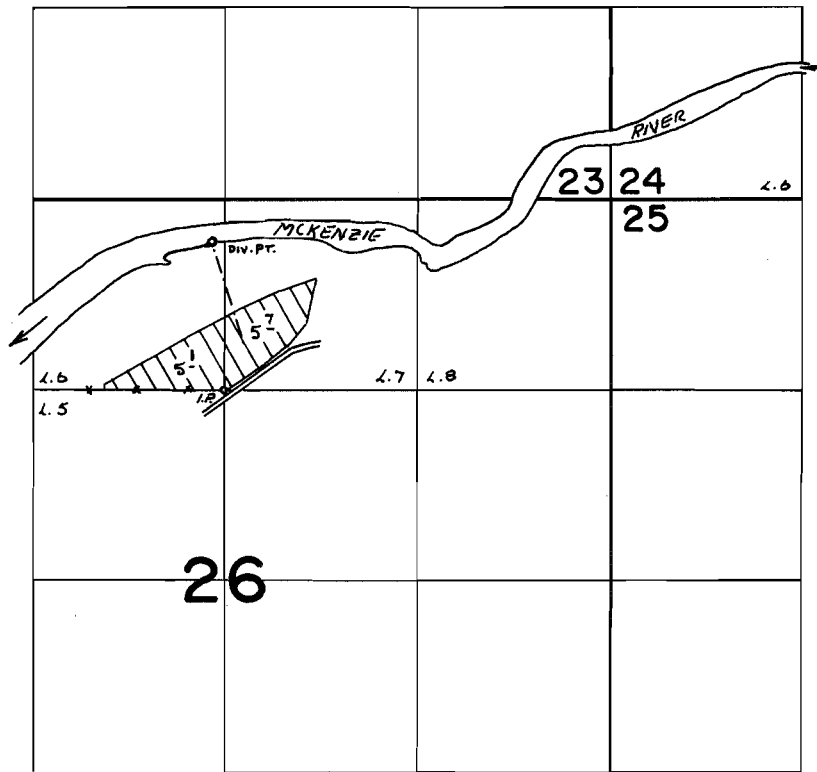

DIV. PT.: 1020' N AND 80' W FROM SE COR Lot 6 SEC 26

FINAL PROOF SURVEY UNDER

Application No. 48605 Permit No. 36464
IN NAME OF

WILBUR E. DEHNE

Surveyed SEPT. 15 1975, by L. Toll