


T.8S.,R.11W.,W.M.

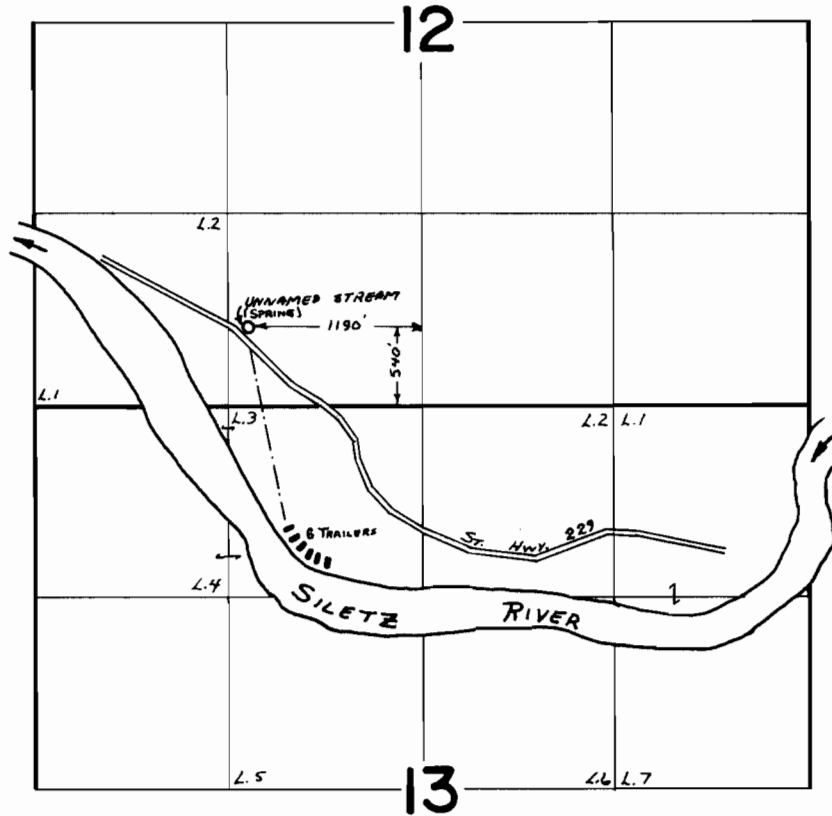

FINAL PROOF SURVEY
UNDER

Application No. **42049**... Permit No. **31527**.....
IN NAME OF

Siletz River Improvement Dist.

Surveyed July 19, 1974, by **D. NORBY**.....