


T.8S. R.IIW. W.M.

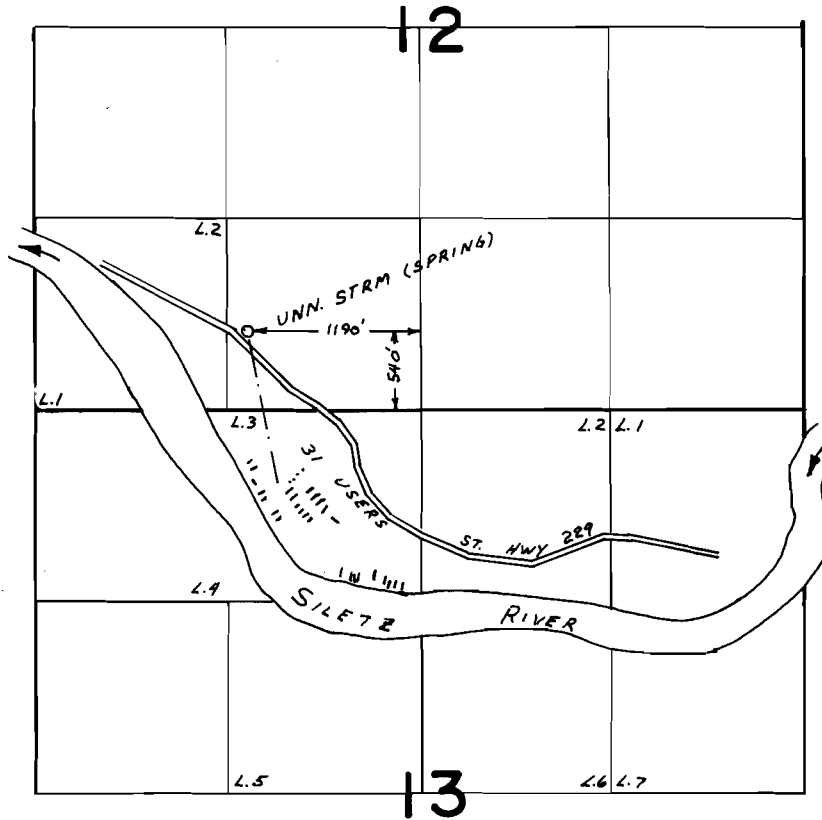

FINAL PROOF SURVEY UNDER

Application No. 48494 Permit No. 36388
IN NAME OF

FUN RIVER IMPROVEMENT DIST.

Surveyed OCT. 9 1975, by L.H. NUNN