


T.12 S., R.1 W., W.M.

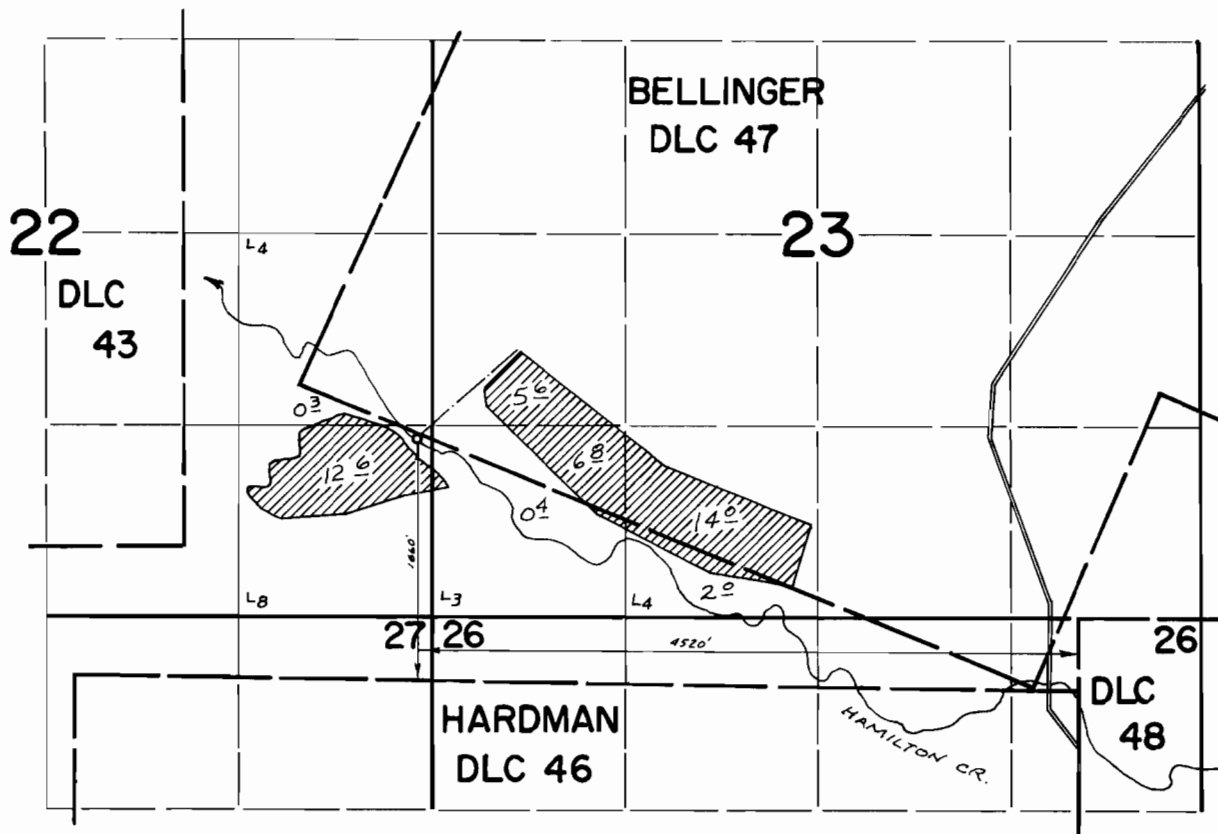

FINAL PROOF SURVEY UNDER

Application No. 42160 Permit No. 31551
IN NAME OF

ADRIAN L. AND KENT D. WILCOX

Surveyed May 23 1974, by D.M. Norby