


T.13S., R.1W., W.M.

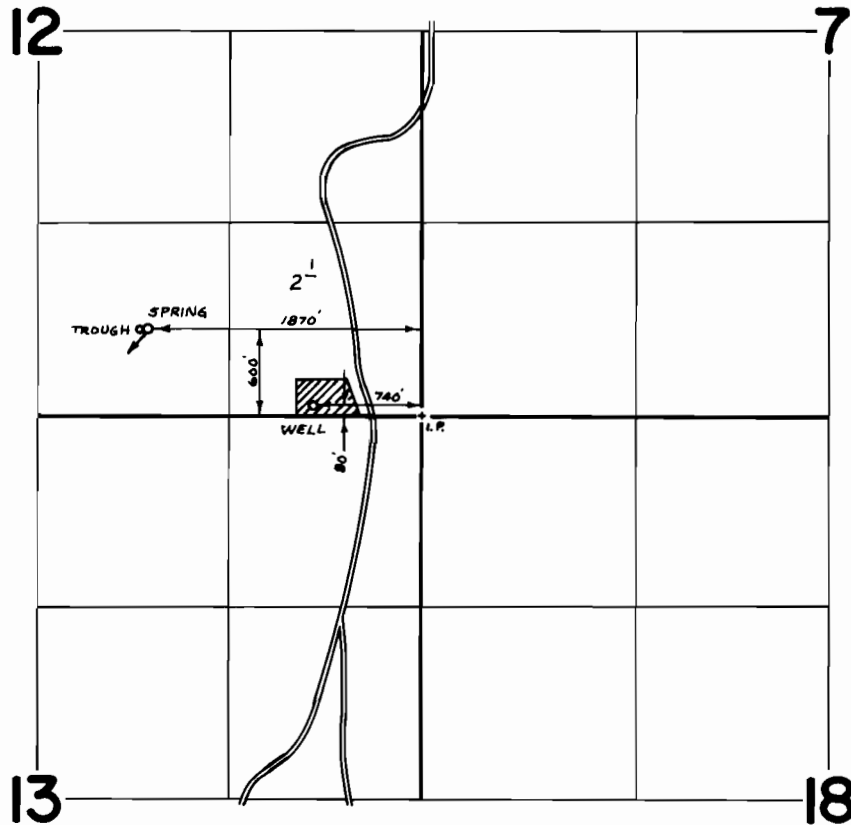

FINAL PROOF SURVEY
UNDER

Application No. G-7208 51368 Permit No. G-6634 38765
IN NAME OF

KAY G. & EILEEN F. SELEEN

Surveyed July 7 1976, by D. Norby