


# T.16S.R.43E.W.M.

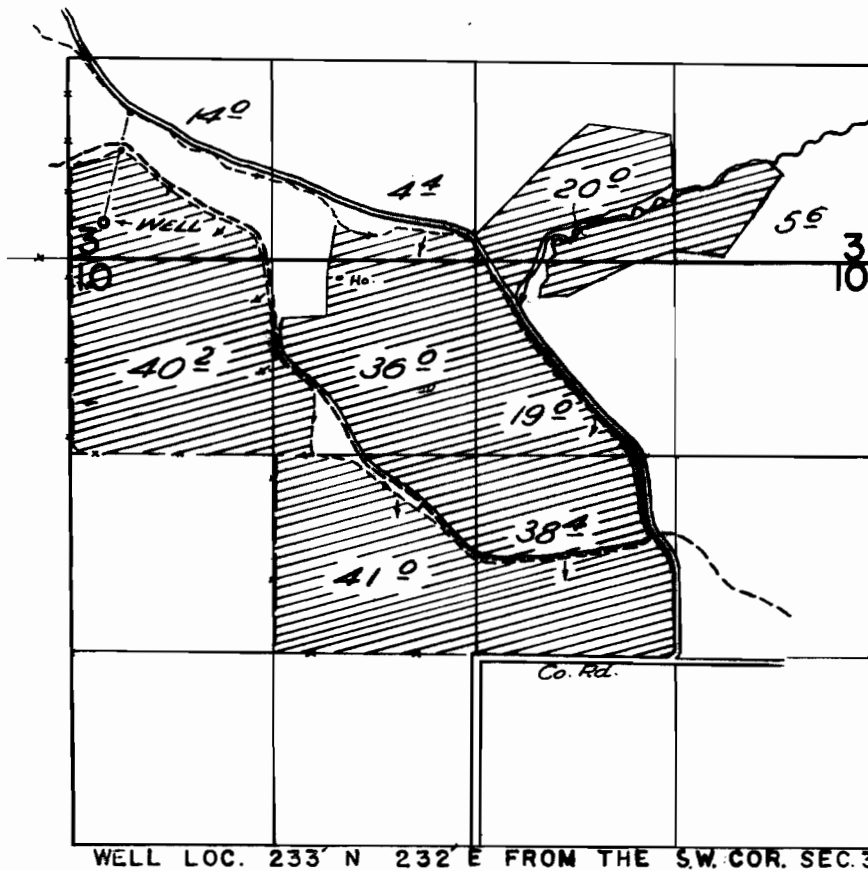

## FINAL PROOF SURVEY UNDER

Application No. G-1452 Permit No. G-1366  
IN NAME OF

STEVEN L. & MARY L. MCBRIDE .....

Surveyed 29 Oct. 1960, by Mr. Bick  
20 Oct. 1961, by Mr. Johnson

1959 Q  
BBC-7N-86  
1961-K