


T.14S. R.41E. W.M.

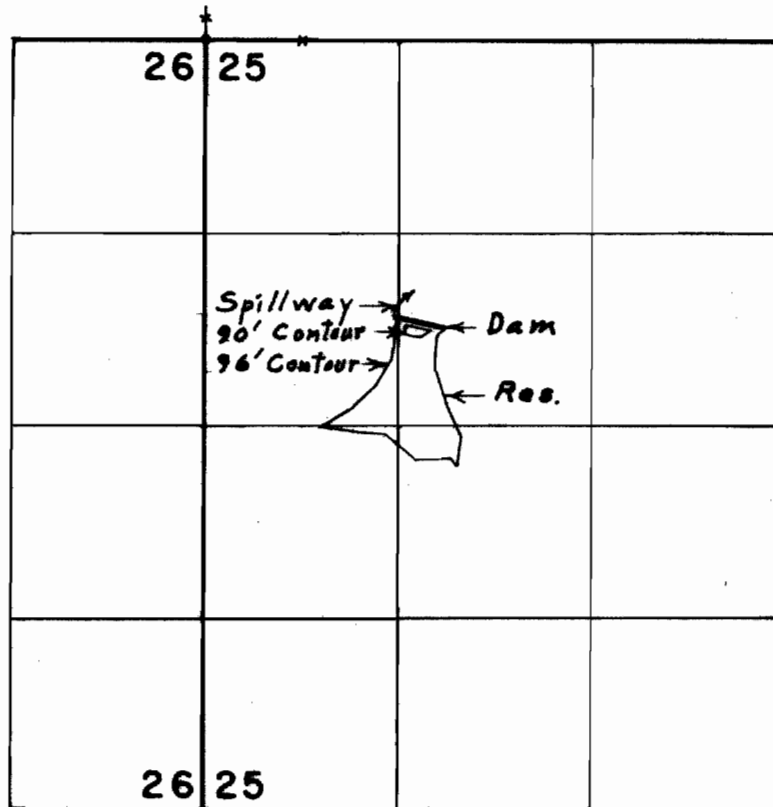

FINAL PROOF SURVEY
UNDER

Application No. R-37341 Permit No. R-2731
IN NAME OF

ESTATE OF EUGENIE (MRS. GUSS) DAVIS

Surveyed April 29, 1975, by L. E. Gauld.