


T.14S. R.39E. W.M.

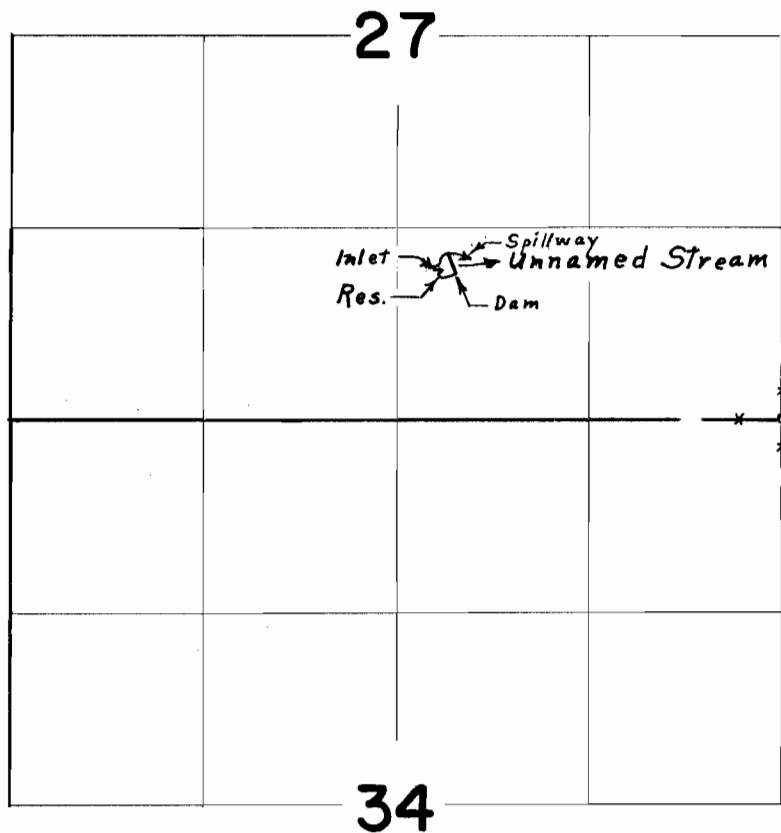

FINAL PROOF SURVEY
UNDER

Application No. R-44419 Permit No. R-5129
IN NAME OF

JOHN MOLTHAN

Surveyed April 22 1975, by L. E. Gould