


T.13S. R.41E. W.M.

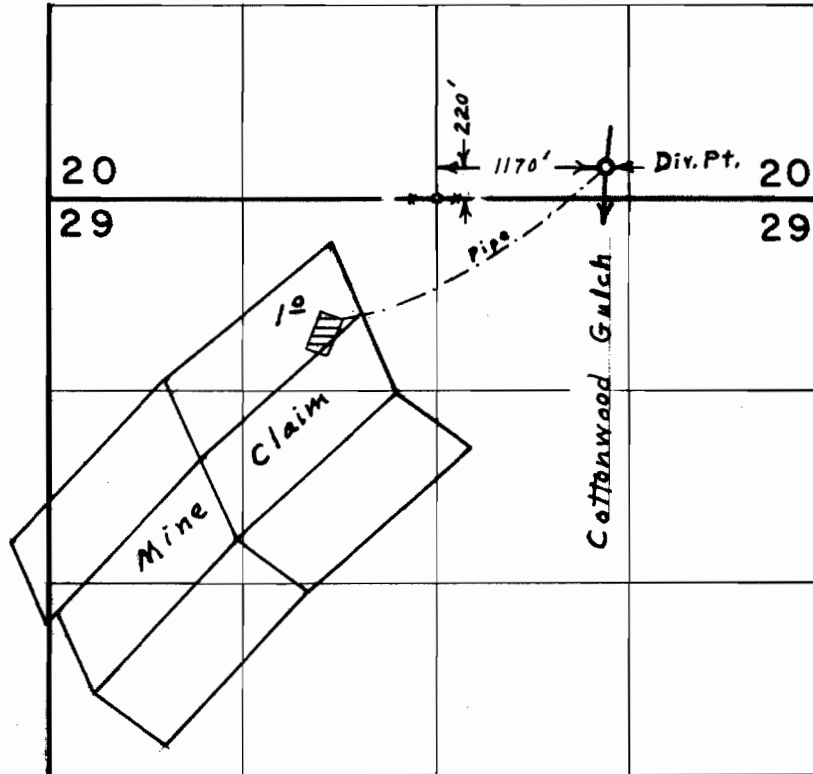

FINAL PROOF SURVEY
UNDER

Application No. 4434 Permit No. 32262
IN NAME OF

MALHEUR CEMETERY ASSOCIATION

Surveyed April 28, 1975, by L. E. Gex, Jr.