


T.14 S. R.41 E. W.M.

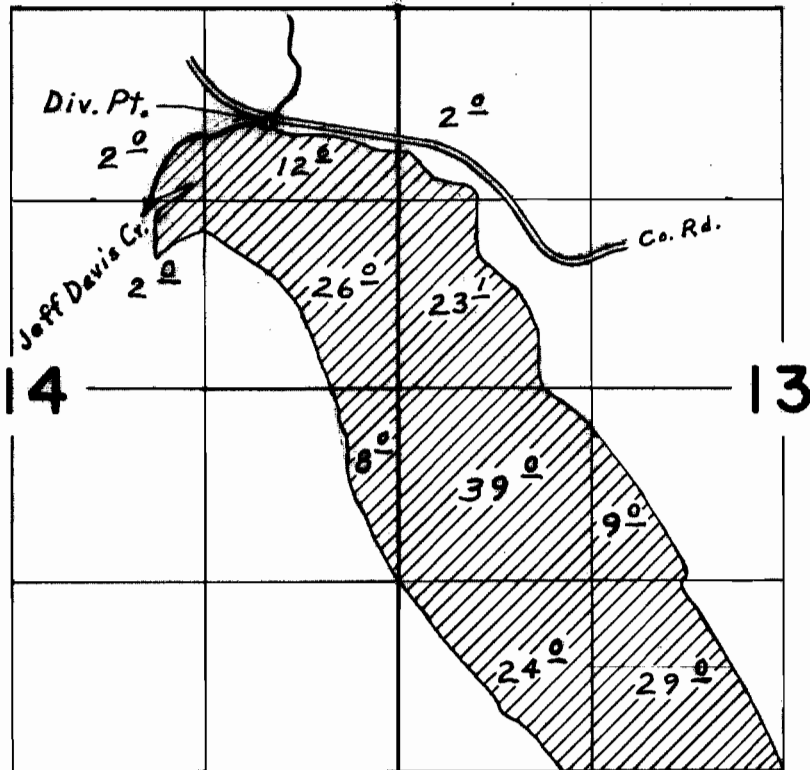

Jeff Davis Cr. div.: 780' S. & 880' W. from N. E. Cor. Sec. 14

Basin Cr. div.: 2230' N & 1280' W from S. E. Cor. Sec. 29

FINAL PROOF SURVEY
UNDER

Application No. 48364 Permit No. 36311
48365 36312
IN NAME OF

FRANCIS DOMBY

Surveyed April 28, 1975, by L. E. Gould