


T.13&14S. R.41E. W.M.

T.13S. R.41E. W.M.

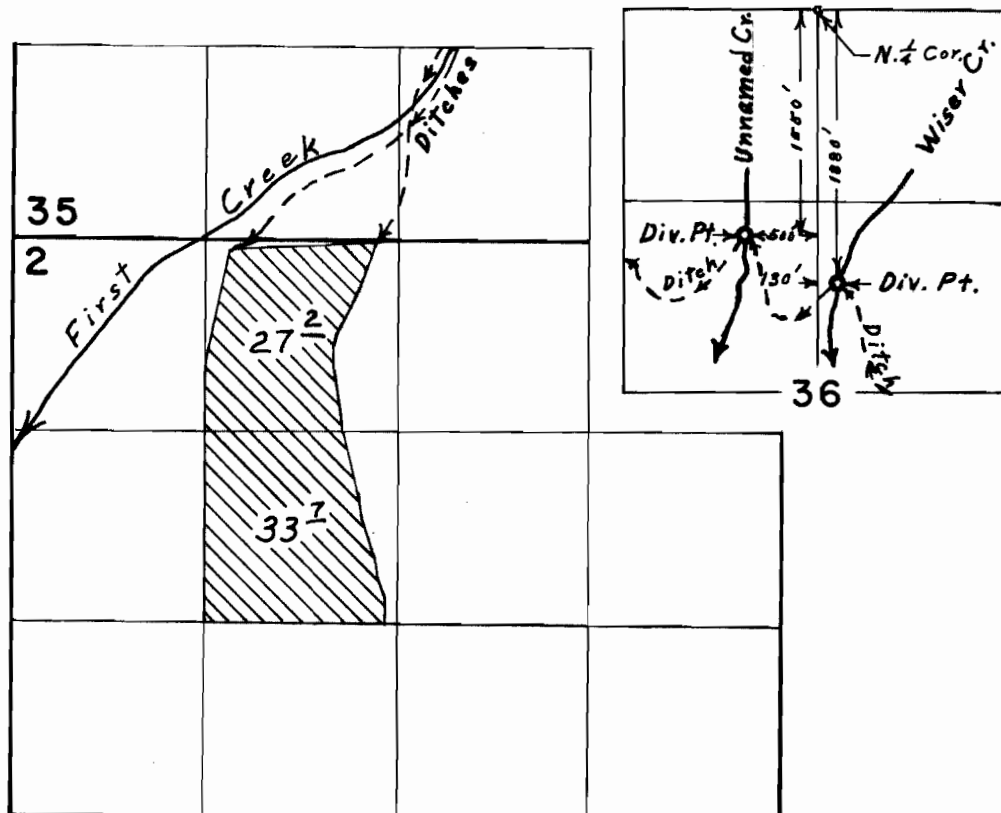

FINAL PROOF SURVEY
UNDER

Application No. 48366 Permit No. 36313

IN NAME OF

FRANCIS DOMBY

Surveyed April 28, 1975, by L. E. Gould