


T.5S.R.2W. W.M.

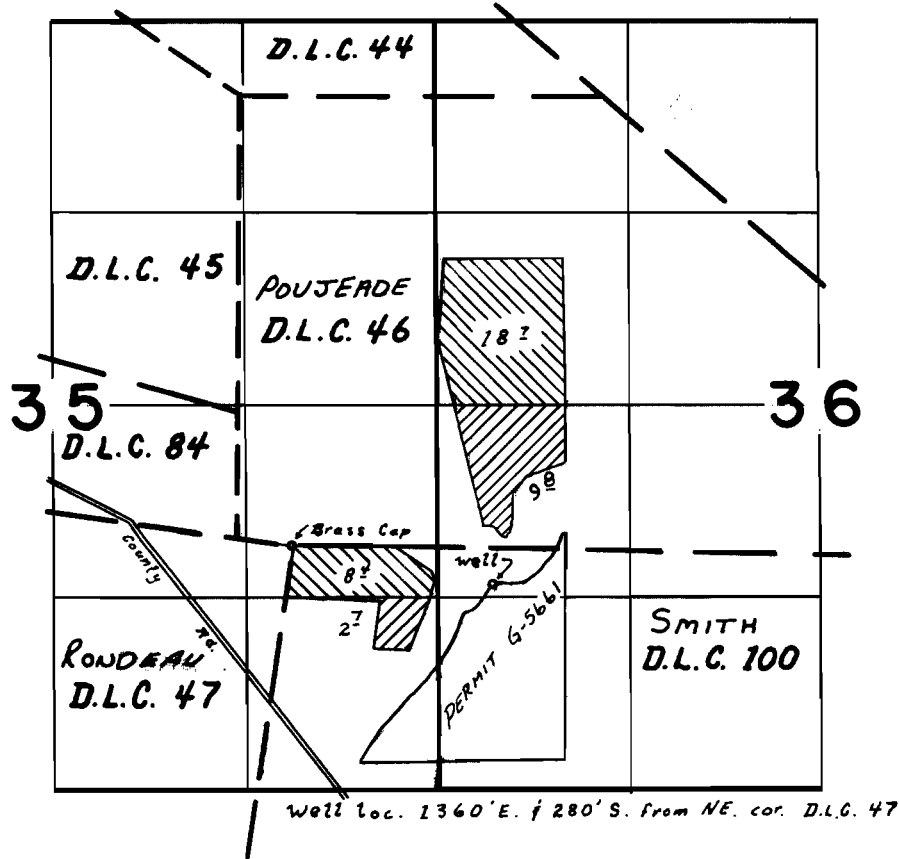

**FINAL PROOF SURVEY**  
UNDER

Application No. G-4558 Permit No. G-4282  
IN NAME OF

John Zellner

Surveyed 11 OCT 1972, by D. D'Reilly