T.5S.,R.2W.,W.M.

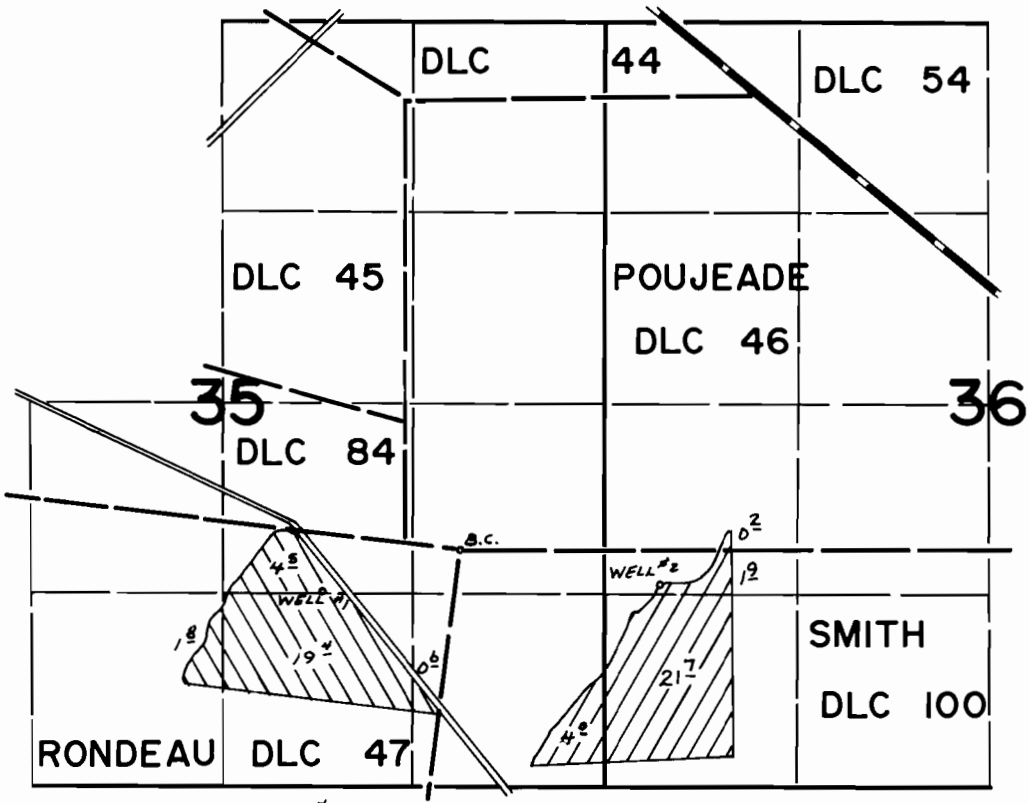

WELL #1 LOC: 270'S AND 940'W
WELL #2 LOC: 280'S AND 1360'E } FROM NE COR RONDEAU DLC 47

FINAL PROOF SURVEY
UNDER

G-5971 G-5661
Application No. G-6387 Permit No. G-5979

IN NAME OF

JOHN ZELLNER

Surveyed APRIL 2 1976, by L. TOLL

OFN-6LL-199