


# T.5S.,R.2W.,W.M.

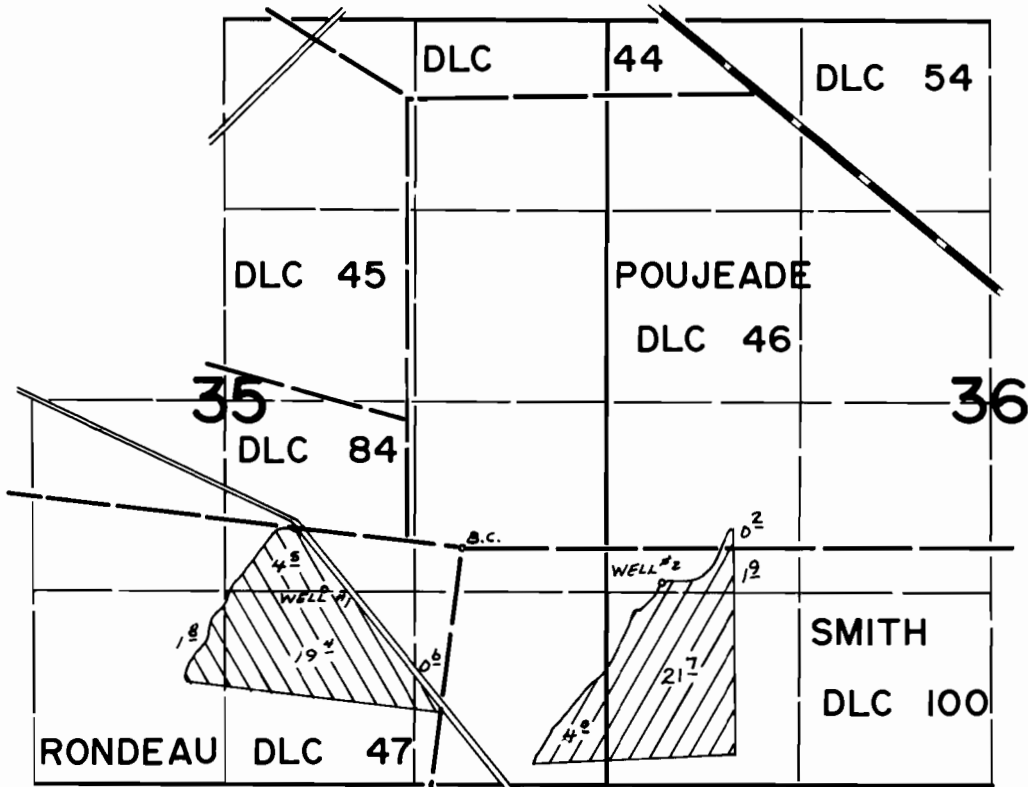

WELL #1 Loc: 270'S AND 940' W } FROM NE COR RONDEAU DLC 47  
 WELL #2 Loc: 280'S AND 1360' E }

## FINAL PROOF SURVEY UNDER

G-5971                      G-5661  
 Application No. G-6387    Permit No. G-5979  
 IN NAME OF



..... JOHN ZELLNER .....

Surveyed APRIL 2, 1976, by L. TOLL .....