


T.7S.R.1E.W.M.

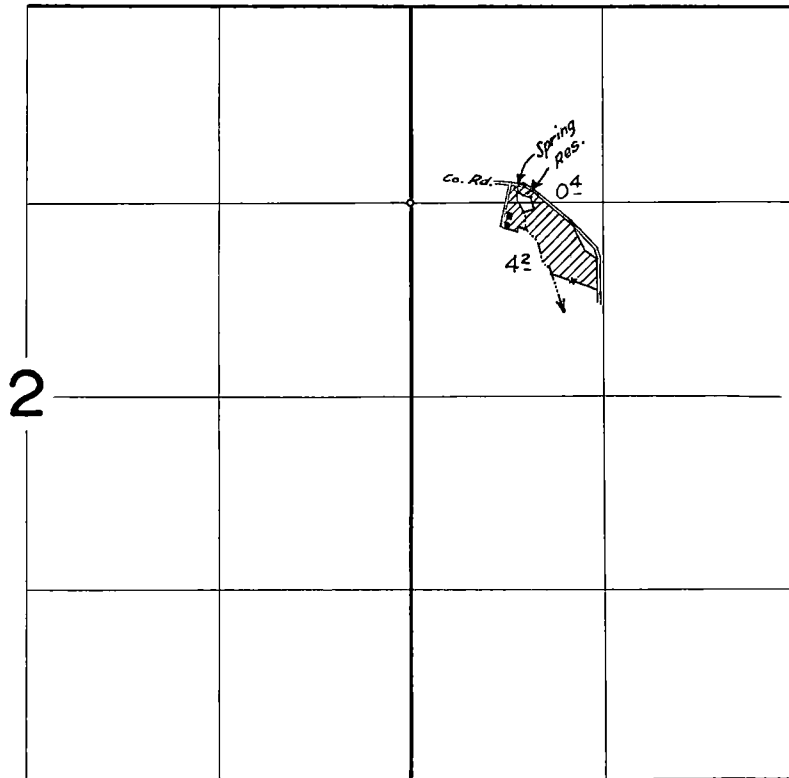

**FINAL PROOF SURVEY**  
UNDER

Application No. **R-31909** **31910** Permit No. **R-2084** **25161**  
IN NAME OF

**DANIEL S. POTTER**

Surveyed May 15, 1962, by *St. Peterson*