


T. 7 S. R. 1 E. W. M.

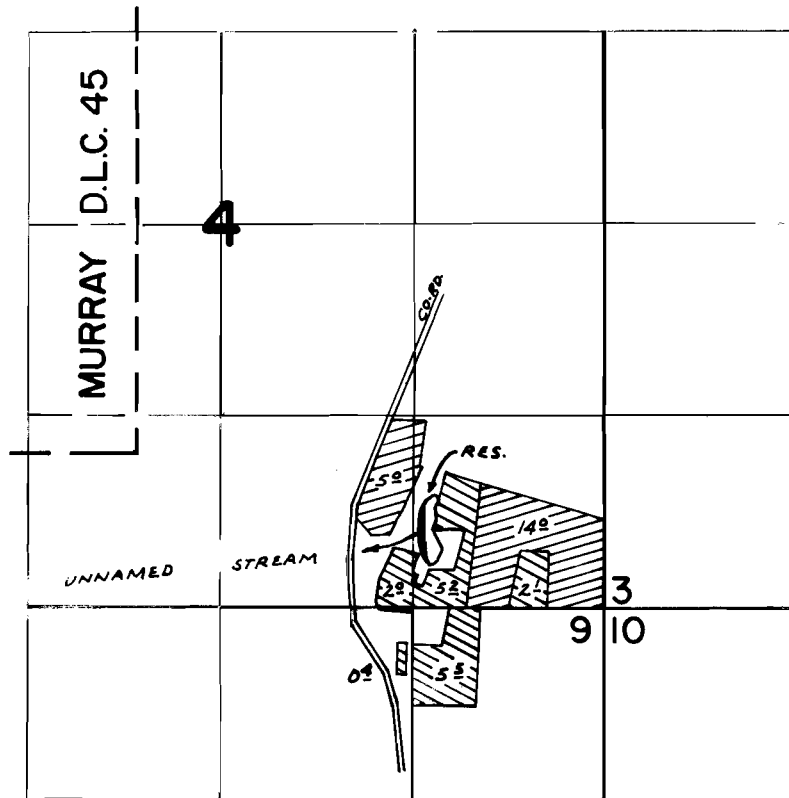

DIV. LOC: 500' N. & 1250' W. FROM S-E COR. SEC. 4

-  PRIMARY
-  SUPPLEMENTAL

FINAL PROOF SURVEY UNDER

Application No. *R-47595* ~~47596~~ Permit No. *R-5612* ~~34996~~
IN NAME OF

LEWIS E. HOUSE

Surveyed *JUNE 2, 1975* by *R.G. MUCKEN*