


T. 1 N. R. 1 & 2 W. W. M.

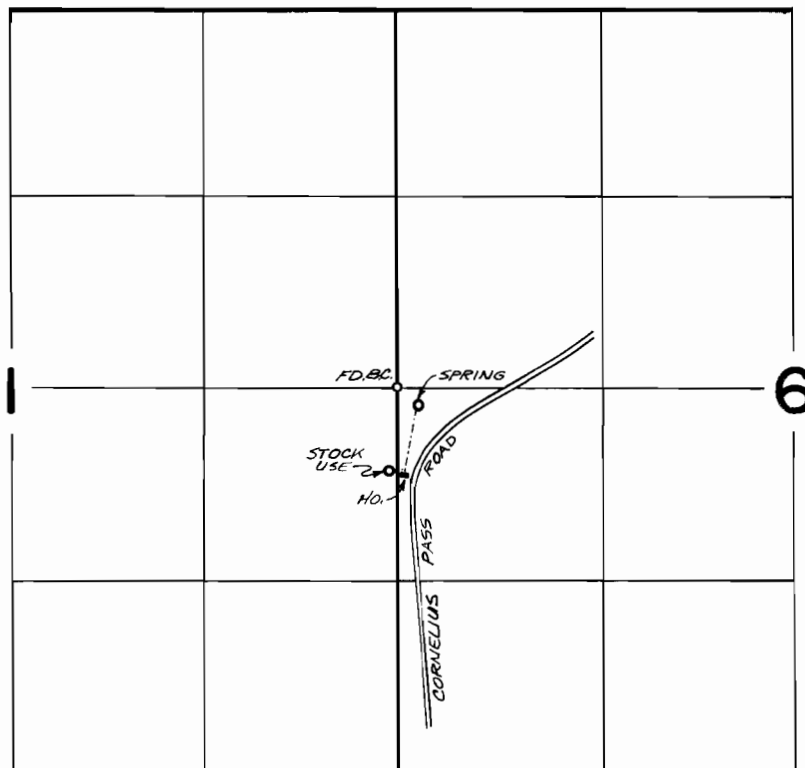

SPRING LOCATED 120' S. & 140' E. FROM W. 1/4 COR. SEC. 6

FINAL PROOF SURVEY UNDER

Application No. 47454 Permit No. 35552
IN NAME OF

DONNA M. SPINT

Surveyed JULY 10, 1975, by RGMUCKEN