


T.9S., R.4W., W.M.

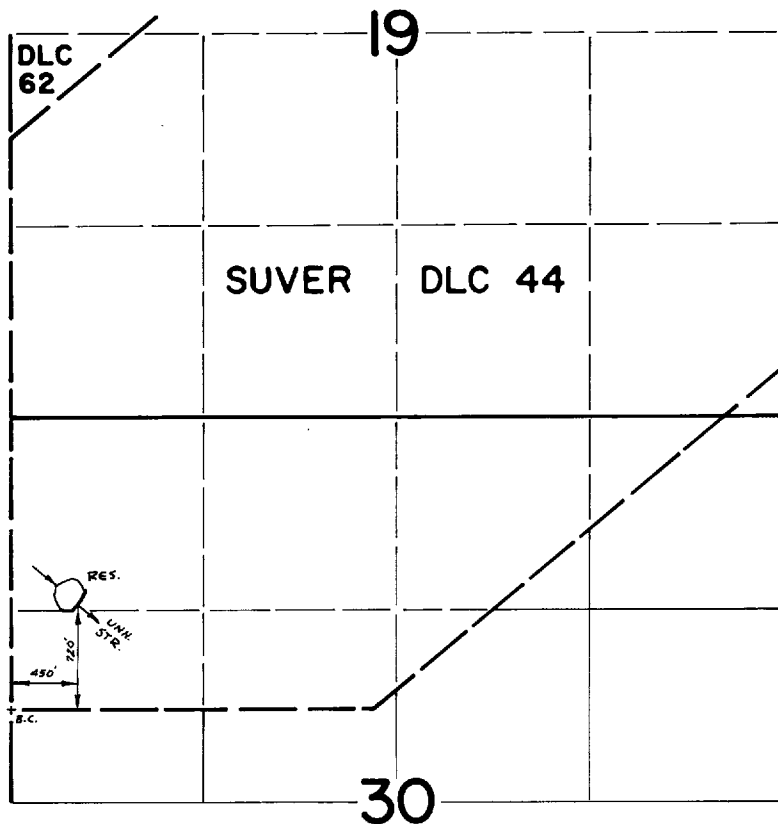

**FINAL PROOF SURVEY**  
UNDER

R-47695                      R-5758  
Application No. 47696      Permit No. 35730  
IN NAME OF

HOWARD SCHWANKE

Surveyed June 30 1975, by D. Norby