


T.9S., R.4W., W.M.

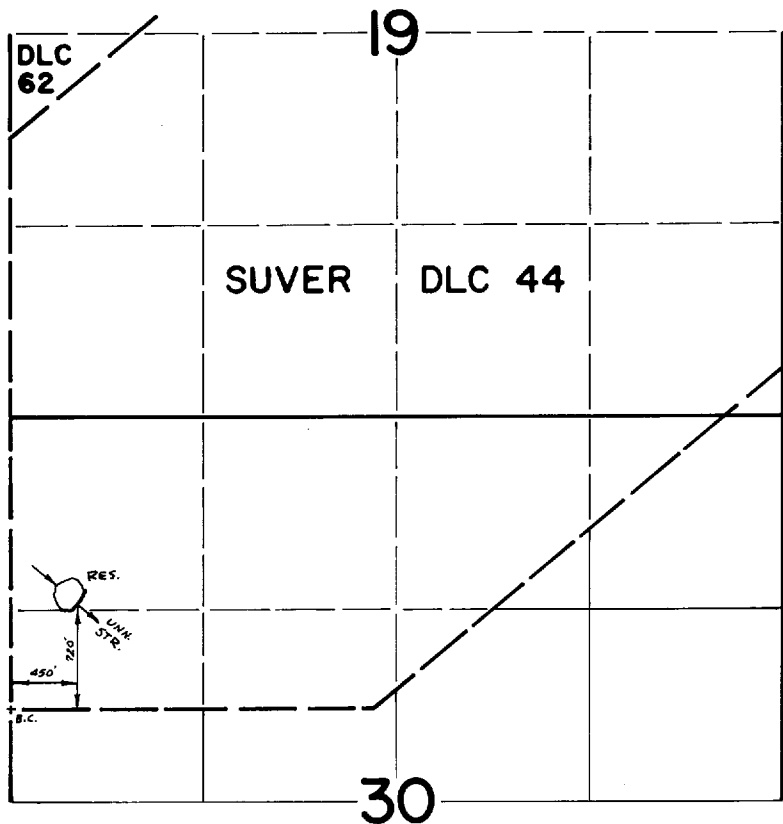

FINAL PROOF SURVEY
UNDER

R-47695 R-5758
Application No. 47696 Permit No. 35730
IN NAME OF

HOWARD SCHWANKE

Surveyed June 30 1975, by D. Norby