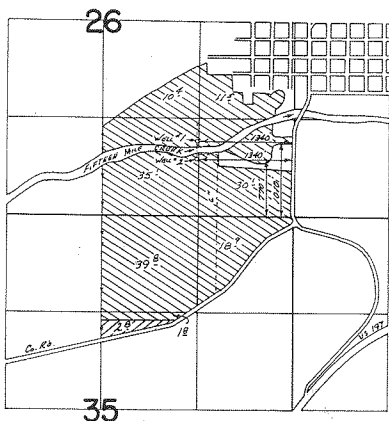

 


T.1S. R.13E. W.M.



 Primary
 Supplemental

FINAL PROOF SURVEY
UNDER

Application No. G-5327. Permit No. G-5279.
IN NAME OF

..... ROY P & LOLA BARNET

Surveyed Oct. 24, 1975, by T. PAUL