


T. 4 S. R. 11 E. W.M.

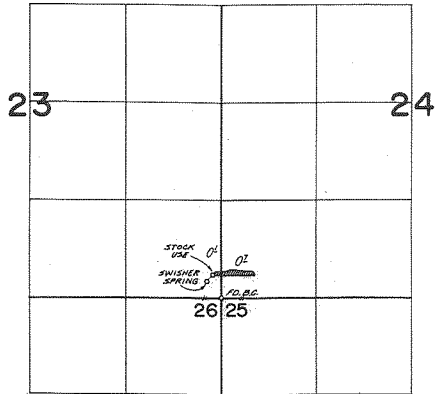

SPRING LOCATED; 220' N. & 200' W. FROM S.E. COR. SEC. 23

FINAL PROOF SURVEY UNDER

Application No. 47330 Permit No. 35456
 IN NAME OF
Oregon State Game Commission
 Surveyed JUNE 5 1975 by R.G.MUCKEN