



T.2N. R.11E. W.M.

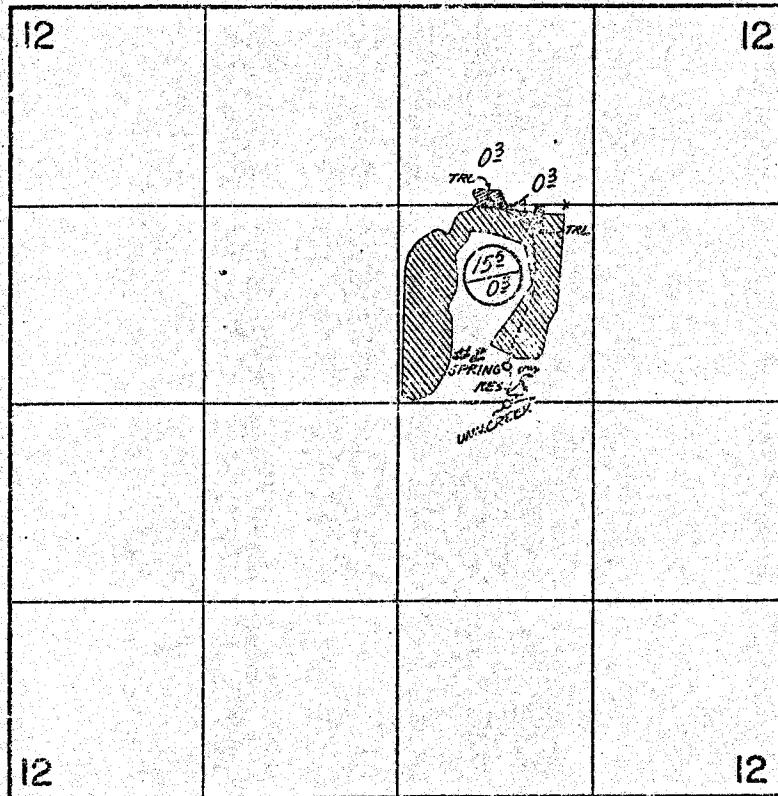

UNN. SPRING 290'N. & 720'E., UNN. CREEK 10'S. & 730'E., RES. 100'N. & 880'E.
ALL FROM CENTER SECTION 12

UNN. SPRING, UNN. CREEK & RESERVOIR  UNN. SPRING 

 PRIMARY
SUPPLEMENTAL

FINAL PROOF SURVEY UNDER

R51810 R6111
Application No. 51478 Permit No. 37763
IN NAME OF
EARL L. HOWARD

Surveyed JULY 17 1975, by T. PAUL